

**SURVEY &  
REMONUMENTATION**

**RC 1449**

**L127794PA324**

**LAND CORNER RECORDATION CERTIFICATE**

**APR 25 1995**

**Filing Requirement of Act 74, Mich. P.A. 1970**

L-05 Page 1

**COMMISSION**

For corners in

Wayne

Located In: Romulus Corner Code

County

- |                                       |                           |             |
|---------------------------------------|---------------------------|-------------|
| 1. Public Land Survey                 | T <u>3</u> S R <u>9</u> E | <u>1-05</u> |
|                                       | T _____ R _____           | _____       |
|                                       | T _____ R _____           | _____       |
|                                       | T _____ R _____           | _____       |
| 2. Property Controlling In Section    | S _____ T _____ R _____   | _____       |
|                                       | S _____ T _____ R _____   | _____       |
| 3. Miscellaneous Property in Sec.     | S _____ T _____ R _____   | _____       |
|                                       | S _____ T _____ R _____   | _____       |
| 4. Lot No. _____, Recorded Plat _____ |                           |             |
| 5. Private Claims _____               |                           |             |

Compliance with  
ACT 345, P.A. 1990

APPROVED ON: 12/9/94 TCO.  
WAYNE COUNTY REMONUMENTATION  
PEER GROUP COMMITTEE

Register of Deeds Stamp and File Number

I, Kenneth S. Wilkerson in a field survey on 06/25/1994  
do hereby certify that under requirements of P.A. 74, Michigan P.A. of 1970, the corner points mentioned in lines 1 and 2 above were in conformance with regulations and rules therefore as required in the current manual of survey instructions of the United States Department of the Interior, Bureau of Land Management, or by a decree of a Court of Law and/or that the corner points mentioned in lines 3, 4 and 5 above were in conformance with the rules of the Michigan Board of Land Surveyors or by a Decree of a Court of Law, established, re-established, monumented, re-monumented, recovered, found as expressed below.

**NOTE: Not more than 4 corners, all in the same town and range, may be recorded on this certificate.**

	A	B	C	D	E	F	G	H	I	J	K	L	M
2	6	5	4	3	2	1							
3													
4	7	8	9	10	11	12							
5													
6	18	17	16	15	14	13							
7													
8	19	20	21	22	23	24							
9													
10	30	29	28	27	26	25							
11													
12	31	32	33	34	35	36							
13													

**A. Description of original monument and accessories and/or subsequent restorations:**

01/01/1816 G.L.O. Set post  
12" MAPLE S 37 E 16 LINKS (10.56')  
12" MAPLE N 11 W 29 LINKS (19.14')

(Witnesses Continued on Back ...)

**B. Description of corner evidence found and/or method applied in restoring or reestablishing corner:**

Fd. 1/2" iron rod w/metal cap in a mon. box w/cover in conc. pvm't @ extended cl's of Wick & Wickham

**C. Description of monument for corner and accessories established to perpetuate locating the position of the corner:**


06/25/1994 Wilkerson 21584 O.H.M. Remon  
SET W.C.R. WASHER OVER CORNER  
9 TOP BOLT ON HYDRANT N 36 W 80.88'  
11 CENTERLINE OF MBT M.H. COVER S 37 E 16.40'  
12 W.C.R. TAG N.W./S P.P. S 46 W 54.39  
13 S.W. BOLT @ LT. POLE BASE N19E 134.89'

15.00 MISCELLANEOUS RECORDING  
21 DEC 94 3:12 P.M. REGISTER# 93A  
REGISTERED  
REGISTER OF DEEDS

We conclude that after careful study of the record documentation and field observations, that this corner is accepted as the best available evidence of the position of the original corner.

Signed by [Signature]  
Drafted by Kenneth S. Wilkerson  
Surveyor's Michigan License No. 21584  
Orchard, Hiltz and McCliment, Inc. 34935 Schoolcraft Road Livonia, MI 48150

Date 12/9/94

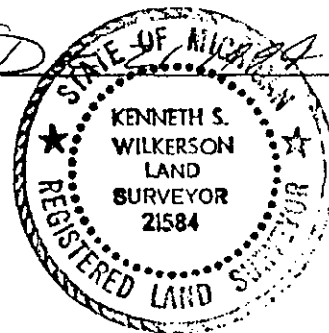

2R  
14-N 1A

## A. (Continued) Description of original monument and accessories and/or subsequent restorations:

	W.C.R.C.	B/T	Fd. iron	
01/01/1930				
1	W.C.R. SIGN POST SE 45.17'			
2	FENCE POST NE 48.27'			
3	FENCE POST NW 47.52'			
14	DIST = 2649.22' TO I-06			
15	DIST = 2596.20' TO H-05			
16	DIST = 2625.29' TO I-04			
17	DIST = 2673.82' TO J-05			
04/01/1970	Qwiggins	M.D.O.T.		
4	WEST 5.0' E. EDGE OF SLAB			
5	D.E. POLE S 85 E 33.08'			
6	D.E. POLE S 25 E 53.51'			
7	M.B.T. POLE N 38 W 64.00'			
05/05/1970		W.C.R.C.	Fd. mon.	
5	D.E. POLE EASTERLY 33.08'			
6	D.E. POLE SE 53.29'			
7	M.B.T. POLE NW 64.00'			
8	D.E. POLE NE 142.90'			
07/24/1972	Papke	9675 O.H.M.	R.C.1	Fd. 1/2" iron pipe
5	P.K. NAIL S.W. FACE OF D.E. POLE EASTERLY 33.17'			
6	P.K. NAIL IN N.W. FACE OF D.E. POLE S 37 E 53.22'			
7	P.K. NAIL IN FACE OF POLE N 30 W 64.05'			
04/01/1981	Erickson	16929	M.D.O.T.	Rerod in conc. cylinder
5	P.K. NAIL S.W. FACE OF D.E. POLE EASTERLY 33.12'			
8	CENTER STEEL LITE POLE N 45 E 87.71'			
9	TOP CENTER F. HYD. N 28 W 81.05'			
10	P.P. S 70 W 110.59'			
05/25/1984	Zbikowski	21586	R.C.8	Fd. conc. mon.
5	P.K. NAIL S.W. FACE OF D.E. POLE S 77 E 33.17'			
6	P.K. NAIL IN N.W. FACE OF D.E. POLE S 37 E 53.22'			
7	P.K. NAIL IN FACE OF POLE N 30 W 64.05'			
9	TOP NUT F. HYD. N 44 W 81.10'			
07/01/1990	Pitts	10702	R.C.9	Fd. 1/2" iron in mon. box
6	P.K. NAIL IN N.W. FACE OF D.E. POLE S 37 E 54.13'			
7	P.K. NAIL IN FACE OF POLE N 30 W 64.08'			
9	P.K. NAIL IN NORTH FACE D.E. POLE N 67 E 35.88'			
10	P.K. NAIL IN N. FACE D.E. POLE S 68 W 110.74'			

L127794PA325