

SURVEY & REMONUMENTATION LAND CORNER RECORDATION CERTIFICATE

LIBER 28477 PAGE 214

APR 05 1996

Filing Requirement of Act 74, Mich. P.A. 1970

I-12 Page 1

For corners in **COMMISSION**
Wayne

Located in: Romulus Corner Code

LIBER 28647 PAGE 719

- County _____
1. Public Land Survey T 3 S R 9 E I-12
 T _____ R _____
 T _____ R _____
 T _____ R _____
2. Property Controlling S _____ T _____ R _____
 in Section S _____ T _____ R _____
3. Miscellaneous S _____ T _____ R _____
 Property in Sec. S _____ T _____ R _____
4. Lot No. _____, Recorded Plat _____
5. Private Claims _____

Compliance with
ACT 345, P.A. 1990

APPROVED ON: 11-30-95 [Signature]
WAYNE COUNTY REMONUMENTATION
PEER GROUP COMMITTEE

Register of Deeds Stamp and File Number

	A	B	C	D	E	F	G	H	I	J	K	L	M
2	6	5	4	3	2	1							
3													
4	7	8	9	10	11	12							
5													
6	18	17	16	15	14	13							
7													
8	19	20	21	22	23	24							
9													
10	30	29	28	27	26	25							
11													
12	31	32	33	34	35	36							
13													

I, Kenneth S. Wilkerson in a field survey on 11/03/1995
do hereby certify that under requirements of P.A. 74, Michigan P.A. of 1970, the corner points mentioned in lines 1 and 2 above were in conformance with regulations and rules therefore as required in the current manual of survey instructions of the United States Department of the Interior, Bureau of Land Management. or by a decree of a Court of Law and/or that the corner points mentioned in lines 3, 4 and 5 above were in conformance with the rules of the Michigan Board of Land Surveyors or by a Decree of a Court of Law, established, re-established, monumented, re-monumented, recovered, found as expressed below.


NOTE: Not more than 4 corners, all in the same town and range, may be recorded on this certificate.

A. Description of original monument and accessories and/or subsequent restorations:
 01/01/1819 G.L.O. Set post
 12" Elm South 18 links (GONE)
 10" W.Ash S 62 W 11 links (GONE)

(Witnesses Continued on Back ...)

B. Description of corner evidence found and/or method applied in restoring or reestablishing corner:
 1/2" Iron pipe .75 below gravel road surface. I-11 IS IN THE AIRPORT (RESTRICTED AREA) DIST TO I-13 2641.13'(R)2640.22(R)

C. Description of monument for corner and accessories established to perpetuate locating the position of the corner:
 11/03/1995 Wilkerson 21584 O.H.M. Remon
 SET W.C.R. REMON CAP AND WASHER OVER CORNER
 11 12" Pine sw face O.H.M. tag and nail N 28 W 81.55'
 12 U.P. O.H.M. K.S.W. tag NW face N 26 E 80.66'
 13 U.P. W.C.R.C. ref. tag S. face S 05 E 30.57'
 14 18" tree O.H.M. K.S.W. tag S 75 E 60.32'

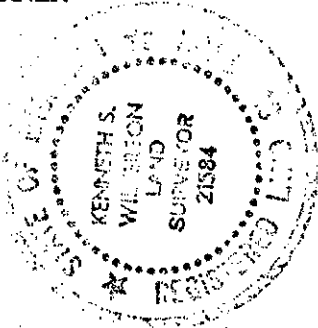

96065629
 95273123
 96 MAR -7 AM 11:27
 FOREST E. YOUNGBLOOD

We conclude that after careful study of the record documentation and field observations, that this corner is accepted as the best available evidence of the position of the original corner.

Signed by [Signature]
 Drafted by Kenneth S. Wilkerson
 Surveyor's Michigan License No. 21584

Date DEC 8 1995

Orchard, Hiltz and McCliment, Inc. 34935 Schoolcraft Road Livonia, MI 48150

RECORD TO ADD PEER GROUP DATE

\$ 10.00 DEED
 21 DEC 95 9:20 A.M. RECEIPT# 5B
 RECORDED
 FOREST E. YOUNGBLOOD, REGISTER OF DEEDS
 WAYNE COUNTY, MI

\$ 4.00 REMONUMENTATION
 \$ 4.00 REMONUMENTATION

AC.
 J.C.
 12/5/95

RECORDED

A. (Continued) Description of original monument and accessories and/or subsequent restorations.

LIBER 28477 PAGE 215

LIBER 28647 PAGE 720

01/01/1930	B/T	G.L.O.	Fd. Iron
1	20" OAK E. 43.75' (GONE)		
2	16" HICKORY S.E. 14.27' (GONE)		
3	12" OAK S. 33.83' (GONE)		
4	10" HICKERY W. 17.08' (GONE)		

04/30/1970	Klopskinske	W.C.R.C.	Fd. iron
5	W.C.R.C. TAG D.E. POLE E. 30.67'		
6	W.C.R.C. S.E. TREE 60.67'		
7	W.C.R.C. 12" ASH S.W. 30.80'		
8	W.C.R.C. P.I. W. 33.07'		

02/09/1987	S.M.	W.C.R.C.	Fd. IRON
9	W.C.R.C. HYD. N.E. 59.83'		
10	W.C.R.C. TAG S.E. D.E. POLE 121.80'		

APR 11 1988 1 - 304 20

FILED DO NOT MAIL