

**SURVEY & REMONUMENTATION**

**RC 1451**

**LAND CORNER RECORDATION CERTIFICATE**

**L127794PA328**

**APR 25 1995**

**Filing Requirement of Act 74, Mich. P.A. 1970**

I-13 Page 1

For County of **COMMISSION**  
**Wayne**

Located in: **Romulus** Corner Code

County

- |                                       |                           |             |
|---------------------------------------|---------------------------|-------------|
| 1. Public Land Survey                 | T <u>3</u> S R <u>9</u> E | <u>1-13</u> |
|                                       | T _____ R _____           | _____       |
|                                       | T _____ R _____           | _____       |
|                                       | T _____ R _____           | _____       |
| 2. Property Controlling in Section    | S _____ T _____ R _____   | _____       |
|                                       | S _____ T _____ R _____   | _____       |
| 3. Miscellaneous Property in Sec.     | S _____ T _____ R _____   | _____       |
|                                       | S _____ T _____ R _____   | _____       |
| 4. Lot No. _____, Recorded Plat _____ |                           |             |
| 5. Private Claims _____               |                           |             |

Compliance with  
**ACT 345, P.A. 1990**

APPROVED ON: 12/9/94 TCO.  
**WAYNE COUNTY REMONUMENTATION  
PEER GROUP COMMITTEE**

**Register of Deeds Stamp and File Number**

	A	B	C	D	E	F	G	H	I	J	K	L	M
2	6	5	4	3	2	1							
3													
4	7	8	9	10	11	12							
5													
6	18	17	16	15	14	13							
7													
8	19	20	21	22	23	24							
9													
10	30	29	28	27	26	25							
11													
12	31	32	33	34	35	36							
13													

I, Kenneth S. Wilkerson in a field survey on 11/03/1994  
do hereby certify that under requirements of P.A. 74, Michigan P.A. of 1970, the corner points mentioned in lines 1 and 2 above were in conformance with regulations and rules therefore as required in the current manual of survey instructions of the United States Department of the Interior, Bureau of Land Management, or by a decree of a Court of Law and/or that the corner points mentioned in lines 3, 4 and 5 above were in conformance with the rules of the Michigan Board of Land Surveyors or by a Decree of a Court of Law, established, re-established, monumented, re-monumented, recovered, found as expressed below.

**NOTE: Not more than 4 corners, all in the same town and range, may be recorded on this certificate.**

A. Description of original monument and accessories and/or subsequent restorations:  
01/01/1816 G.L.O. Set post  
**20" B. OAK CORNER TREE. (GONE)**  
**CORNER COMMON TO HURON TWP.**

(Witnesses Continued on Back ...)

B. Description of corner evidence found and/or method applied in restoring or reestablishing corner:  
Fd. 1/2" iron rod (0.70' below surface) in mon. box w/cover in asph. pvm't. @ int. of cl's of Rds. Dist. to H-13 = 2640.51' (R), 2641.72' (M) & Dist to J-13 = 2643.10 (R), 2642.26' (M)


C. Description of monument for corner and accessories established to perpetuate locating the position of the corner:  
11/03/1994 Wilkerson 21584 O.H.M. Remon  
**SET W.C.R. WASHER AND CAP OVER CORNER.**  
**CORNER COMMON TO HURON TWP.**  
5 S.E. COR. OF HSE.#16850 N 30 W 81.00'  
7 W.C.R. TAG S./S P.P. S 10 W 45.20'  
8 W.C.R. TAG N./S P.P. S 25 E 41.80'  
9 W.C.R. TAG S./S P.P. N 40 E 60.50'  
10 W.C.R. TAG N./S P.P. N 20 W 59.05'  
13 ANGLE TO R. B.S. H-13 = 179-46'24"

\* 14.00 MISCELLANEOUS RECORDING  
21 DEC 94 3:42 P.M. RECEIPT# 93A  
REGISTER OF DEEDS

We conclude that after careful study of the record documentation and field observations, that this corner is accepted as the best available evidence of the position of the original corner.

Signed by [Signature]  
Drafted by Kenneth S. Wilkerson  
Surveyor's Michigan License No. 21584

Date Dec 21 1994

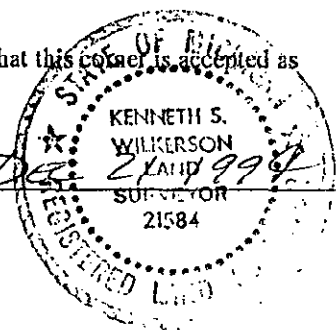

Orchard, Hiltz and McCliment, Inc. 34935 Schoolcraft Road Livonia, MI 48150

2 R  
14.11 11111

A. (Continued) Description of original monument and accessories and/or subsequent restorations:

01/01/1930 W.C.R.C. B/T Fd. iron

- 1 W.C.R. SIGN POST NE 31.58' (GONE)
- 2 20" POPLAR NE 79.0' (GONE)
- 3 FENCE POST SE 47.31' (GONE)
- 4 4" SYCAMORE SW 39.61' (GONE)
- 5 COR. OF HOUSE #16850 NW 81.36'
- 11 DIST = 2640.51' TO H-13
- 12 DIST = 2643.10' TO J-13
- 13 ANGLE TO R B.S. H-13 = 179-43'20"

L127794PA329

04/30/1970 W.C.R.C. Fd. mon.

- 5 COR. OF HOUSE #16850 NW 81.38'
- 6 28" OAK SE 102.90' (GONE)
- 7 M.B.T. POLE SW 45.60'

02/27/1973 Thomas 15414 Metro Engineers Certificate Not stated  
 NO WITNESSES ON SURVEY