

LAND CORNER RECORDATION CERTIFICATE

Filing Requirement of Act 74, Mich. P.A. 1970

For corners in

Wayne

Located in: Romulus Corner Code

L129366PA881

County

- | | | | |
|---------------------------------------|---------|---------------------------|-------|
| 1. Public Land Survey | | T <u>3</u> S R <u>9</u> E | J-11 |
| | | T _____ R _____ | _____ |
| | | T _____ R _____ | _____ |
| | | T _____ R _____ | _____ |
| 2. Property Controlling in Section | S _____ | T _____ R _____ | _____ |
| | S _____ | T _____ R _____ | _____ |
| 3. Miscellaneous Property in Sec. | S _____ | T _____ R _____ | _____ |
| | S _____ | T _____ R _____ | _____ |
| 4. Lot No. _____, Recorded Plat _____ | | | |
| 5. Private Claims _____ | | | |

Compliance with
ACT 345, P.A. 1990

APPROVED ON: 12-16-96 *PBJ*
WAYNE COUNTY REMONUMENTATION
PEER GROUP COMMITTEE

Register of Deeds Stamp and File Number

I, Kenneth S. Wilkerson in a field survey on 12/04/1996
do hereby certify that under requirements of P.A. 74, Michigan P.A. of 1970, the corner points mentioned in lines 1 and 2 above were in conformance with regulations and rules therefore as required in the current manual of survey instructions of the United States Department of the Interior, Bureau of Land Management. or by a decree of a Court of Law and/or that the corner points mentioned in lines 3, 4 and 5 above were in conformance with the rules of the Michigan Board of Land Surveyors or by a Decree of a Court of Law, established, re-established, monumented, re-monumented, recovered, found as expressed below.

NOTE: Not more than 4 corners, all in the same town and range, may be recorded on this certificate.

	A	B	C	D	E	F	G	H	I	J	K	L	M
2	6	5	4	3	2	1							
3													
4	7	8	9	10	11	12							
5													
6	18	17	16	15	14	13							
7													
8	19	20	21	22	23	24							
9													
10	30	29	28	27	26	25							
11													
12	31	32	33	34	35	36							
13													

A. Description of original monument and accessories and/or subsequent restorations:

01/01/1816 G.L.O. Set post.
12" ELM S. 16 E. 18 Links (GONE)
19" B. ASH N.75 W. 15 Links (GONE)

(Witnesses Continued on Back ...)

B. Description of corner evidence found and/or method applied in restoring or reestablishing corner:

1/2" IR 17" below top of mon box. dist to k-11 = 2673.41'(R) 2673.76'(M) and to I-11 is in the airport. (Eureka Rd. - Asph.)

C. Description of monument for corner and accessories established to perpetuate locating the position of the corner:

12/04/1996 Wilkerson 21584 O.H.M. REMON
SET WCR CAP OVER FD. 1/2" IP
15 W.C.R. TAG IN N FACE DE POLE S77E 169.16'
16 W.C.R. TAG IN W FACE DE POLE S23E 51.98'
17 W.C.R. TAG IN DE POLE N FACE S74W 164.66'
18 TAG & NAIL IN S FACE OF WOOD GUY POLE N78W 151.34'

\$ 4.00 REMONUMENTATION


\$ 10.00 DEED

30 DEC 96 1:36 P.M. RECEIPT# 44B
RECORDED
FOREST E. YOUNGBLOOD, REGISTER OF DEED
WAYNE COUNTY, MI

We conclude that after careful study of the record documentation and field observations, that this corner is accepted as the best available evidence of the position of the original corner

Signed by *Kenneth S. Wilkerson*
Drafted by Kenneth S. Wilkerson
Surveyor's Michigan License No. 21584
Orchard, Hiltz and McCliment, Inc. 34935 Schoolcraft Road Livonia, MI 48150

Date DEC 26 1996

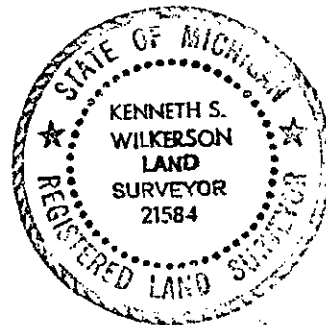

A. (Continued) Description of original monument and accessories and/or subsequent restorations:

01/01/1930

B/T

Set iron

LI29366PA882

- 1 CULVERT N. 46.05'
- 2 CULVERT N.E. 67.68'
- 3 18" ELM SE 55.85' (GONE)
- 4 26" ELM SE 55.85' (GONE)
- 5 MON. SE 50.17'
- 6 24" ELM SE 42.03' (GONE)
- 7 MON LEAD POINT S 40.04'

05/04/1970

KLOPSKINSKE

W.C.R.C.

IRON

- 8 CORNER FIRE STATION NE 106.08' (GONE)
- 9 CORNER FIRE STATION NE 93.04' (GONE)
- 10 MBT N 53.45' (GONE)

02/16/1972

Knapp

44

- 16 S20E 52.42' PK NAIL IN UTILITY POLE
- 19 N35E 49.21' SET PK IN CONC. HEADWALL
- 20 N50W 109.68' PK NAIL IN NE FACE 16" WILLOW

06/29/1973

P. JACKA

W.C.R.C.

IRON ROD

- 11 P.K. IN WOODEN GUARD POST NW 13.09' (GONE)
- 12 P.K. IN WOODEN GUARD POST NE 14.85' (GONE)
- 13 AERIAL SURVEY CROSS S 15.19' (GONE)
- 14 P.K. IN WOODEN GUARD POST N 5.12' (GONE)