

SURVEY & REMONUMENTATION

LIBER 28477 PAGE 216

LAND CORNER RECORDATION CERTIFICATE

APR 05 1996

Filing Requirement of Act 74, Mich. P.A. 1970

J-13 Page 1

For corners of **COMMISSION**

Wayne

Located in: Romulus Corner Code

LIBER 28647 PAGE 717

1. Public Land Survey	T	3	S	R	9	E	J-13
	T			R			
	T			R			
	T			R			
2. Property Controlling in Section	S			T	13	R	
	S			T		R	
3. Miscellaneous Property in Sec.	S			T		R	
	S			T		R	
4. Lot No. _____, Recorded Plat _____							
5. Private Claims _____							

Compliance with ACT 345, P.A. 1990
 APPROVED ON: 11-30-95
 WAYNE COUNTY REMONUMENTATION PEER GROUP COMMITTEE

Register of Deeds Stamp and File Number

	A	B	C	D	E	F	G	H	I	J	K	L	M
2	6	5	4	3	2	1							
3													
4	7	8	9	10	11	12							
5													
6	18	17	16	15	14	13							
7													
8	19	20	21	22	23	24							
9													
10	30	29	28	27	26	25							
11													
12	31	32	33	34	35	36							
13													

I, Kenneth S. Wilkerson in a field survey on 06/21/1995 do hereby certify that under requirements of P.A. 74, Michigan P.A. of 1970, the corner points mentioned in lines 1 and 2 above were in conformance with regulations and rules therefore as required in the current manual of survey instructions of the United States Department of the Interior, Bureau of Land Management. or by a decree of a Court of Law and/or that the corner points mentioned in lines 3, 4 and 5 above were in conformance with the rules of the Michigan Board of Land Surveyors or by a Decree of a Court of Law, established, re-established, monumented, re-monumented, recovered, found as expressed below.

NOTE: Not more than 4 corners, all in the same town and range, may be recorded on this certificate.

A. Description of original monument and accessories and/or subsequent restorations:

01/01/1816
 16" LYNN N 34 W 58 LINKS (GONE)
 12" HICKORY N 29 E 51 LINKS (GONE)

G.L.O. SET POST

(Witnesses Continued on Back ...)


B. Description of corner evidence found and/or method applied in restoring or reestablishing corner:

FD. 1/2" SOLID ROD IN MON. BOX. DIST. TO K-13 = 2643.66 (R), 2644.09' (M); DIST TO I-13 = 2643.10' (R), 2642.26' (M)

C. Description of monument for corner and accessories established to perpetuate locating the position of the corner:

06/21/1995 Wilkerson 21584 O.H.M. Remon

- CORNER IS COMMON WITH TWP. TO THE SOUTH.
- SET W.C.R. REMON CAP & WASHER OVER FD. 1/2" IRON ROD.
- 6 H.B.T. POLE NAIL IN N FACE S 24 E 96.27'
- 8 P.P. PK NAIL E FACE N 02 W 51.86'
- 9 22" WILLOW O.H.M. K.S.W. TAG N 12 E 74.78'
- 10 30" WILLOW W. FACE O.H.M. K.S.W. TAG N 40 E 70.97'

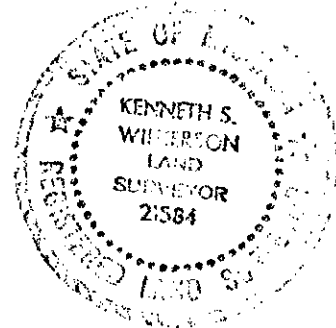

95273124
 96065628

96 MAR -7 AM 11:27
 FOREST E. YOUNGBLOOD

We conclude that after careful study of the record documentation and field observations, that this corner is accepted as the best available evidence of the position of the original corner

Signed by [Signature] Date DEC 8 1995

Drafted by Kenneth S. Wilkerson

Surveyor's Michigan License No. 21584

Orchard, Hiltz and McCliment, Inc. 34935 Schoolcraft Road Livonia, MI 48150

RERECORD TO ADD PEER GROUP DATE

\$ 10.00 DEED
 21 DEC 95 9:20 A.M. RECEIPT# 58
 RECORDED
 FOREST E. YOUNGBLOOD, REGISTER OF DEEDS
 WAYNE COUNTY, MI

\$ 4.00 REMONUMENTATION
 100 AS
 N/C PER I.C.

A. (Continued) Description of original monument and accessories and/or subsequent restorations:

LIBER 28477 PAGE 217

05/01/1970 KLOPSKINSKE W.C.R.C.

IRON IN MON BOX

5 HOUSE CORNER # 30220 NE 118.71'

6 MBT SE 96.43'

7 MBT SW 145.95' (GONE)

LIBER 28647 PAGE 718

28 MAR - 1 11:11 AM '70