

CURTIS B.
 FEB 28 1991

RC 1346
 LAND CORNER RECORDATION CERTIFICATE
 Filing Requirement of Act 74, Mich. P.A. 1970

L127042PA368

For corners in WAYNE
 County:

ROMULUS TOWNSHIP #13 Located in: Corner Code #

1. Public Land Survey		T 3 S	R 9 E	K-03
		T	R	
		T	R	
		T	R	
2. Property Controlling in Section	S	T	R	
	S	T	R	
3. Miscellaneous Property in Sec.	S	T	R	
	S	T	R	

4. Lot No. _____, Recorded Plat _____

5. Private Claims _____

Compliance with
 ACT 345, P.A. 1990
 APPROVED ON: 12-15-93 *RS*
 WAYNE COUNTY REMONUMENTATION
 PEER GROUP COMMITTEE

Register of Deeds Stamp & File Number

I, Kenneth S. Wilkerson, in a field survey on October 28, 19 93, do hereby certify that under requirements of P.A. 74, Michigan P.A. of 1970, the corner points mentioned in lines 1 and 2 above were in conformance with regulations and rules therefore as required in the current manual of survey instructions of the United States Department of the Interior, Bureau of Land Management or by a decree of a Court of Law and/or that the corner points mentioned in lines 3, 4 and 5 above were in conformance with the rules of the Michigan Board of Land Surveyors or by a Decree of a Court of Law; established, re-established, monumented, re-monumented, recovered, found as expressed below:

NOTE: Not more than 4 corners, all in the same town and range, may be recorded on this certificate.

A. Description of original monument and accessories and/or subsequent restoration:

- K-03 Set Post - GLO - NO GLO WITNESSES REMAIN
 Fd. Iron Pipe - B of T
- K-03 Fd. mon. in mon. box, L. 20402, P. 911 - 10/27/77
- N 33.00 iron
- NE 49.40 nail in NW face PP
- SE 39.40 MH
- S 33.00 iron
- SW 55.13 nail in SE face PP
- NW 48.40 MH
- NW 48.19 nail in SW face PP

B. Description of corner evidence found and/or method applied in restoring or reestablishing corner:

- K-03 Fd. mon. in mon. box per L. 20402, P. 911
- N 44 E 73.83 PK in NW face PP, fd.
- N 53 E 57.44 WCRC tag in SE face P, gone
- S 60 E 64.08 WCRC tag SW face MBT P, gone
- S 43 W NE edge ST MH
- N 58 W 64.50 WCRC tag SW face MBT P, gone
- N 49 W 79.49 PK in NE face PP, fd.

C. Description of monument for corner and accessories established to perpetuate locating the position of the corner:

Set WC remonumentation washer and OHM KSW 21584 cap on iron.

- K-03 N 51 E 73.56 OHM tag in NW face PP
- S 39 E 65.58 OHM tag in SW face GP
- S 52 W 73.50 OHM tag in SE face GP
- N 42 N 79.24 OHM tag in NE face PP


The selected location is accepted as the best evidence of the original corner.

Signed by: *Kenneth S. Wilkerson*

Date: Nov 1993

Drafted By: Kenneth S. Wilkerson
 Surveyor's Michigan License No. 21584

Orchard, Hiltz & McCliment, Inc.
 34935 Schoolcraft Road * Livonia, Michigan 48150 * Phone: (313) 522-6711

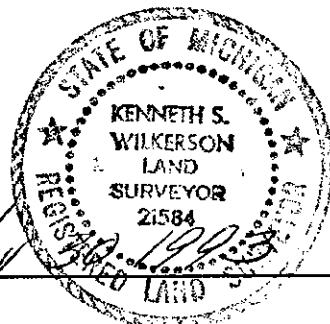

FORM APPROVED BY MICHIGAN STATE BOARD OF LAND SURVEYORS, JAN. 28, 1971
 REVISED MAY 14, 1975
 REVISED JAN., 1983

*2R
 11K1*

RC 1346

93 DEC 15 PM 5:00
