

APR 05 1996

LAND CORNER RECORDATION CERTIFICATE  
Filing Requirement of Act 74, Mich. P.A. 1970

K-09 Page 1

COMMISSION

For corners in

Wayne

Located in: Romulus Corner Code

County

- 1. Public Land Survey T 3 S R 9 E K-09
- T \_\_\_\_\_ R \_\_\_\_\_
- T \_\_\_\_\_ R \_\_\_\_\_
- T \_\_\_\_\_ R \_\_\_\_\_
- 2. Property Controlling S \_\_\_\_\_ T \_\_\_\_\_ R \_\_\_\_\_
- in Section S \_\_\_\_\_ T \_\_\_\_\_ R \_\_\_\_\_
- 3. Miscellaneous S \_\_\_\_\_ T \_\_\_\_\_ R \_\_\_\_\_
- Property in Sec. S \_\_\_\_\_ T \_\_\_\_\_ R \_\_\_\_\_
- 4. Lot No. \_\_\_\_\_, Recorded Plat \_\_\_\_\_
- 5. Private Claims \_\_\_\_\_

LIBER 28647 PAGE 715

Compliance with  
ACT 345, P.A. 1990

APPROVED ON: 11-30-95  
WAYNE COUNTY REMONUMENTATION  
SPECIAL GROUP COMMITTEE

Register of Deeds Stamp and File Number

I, Kenneth S. Wilkerson in a field survey on 06/21/1995  
do hereby certify that under requirements of P.A. 74, Michigan P.A. of 1970, the corner points mentioned in lines 1 and 2 above were in conformance with regulations and rules therefore as required in the current manual of survey instructions of the United States Department of the Interior, Bureau of Land Management. or by a decree of a Court of Law and/or that the corner points mentioned in lines 3, 4 and 5 above were in conformance with the rules of the Michigan Board of Land Surveyors or by a Decree of a Court of Law, established, re-established, monumented, re-monumented, recovered, found as expressed below.

NOTE: Not more than 4 corners, all in the same town and range, may be recorded on this certificate.


	A	B	C	D	E	F	G	H	I	J	K	L	M
2	6	5	4	3	2	1							
3													
4	7	8	9	10	11	12							
5													
6	18	17	16	15	14	13							
7													
8	19	20	21	22	23	24							
9													
10	30	29	28	27	26	25							
11													
12	31	32	33	34	35	36							
13													

A. Description of original monument and accessories and/or subsequent restorations:  
01/01/1816 G.L.O. SET POST  
10" W. ASH S 71 E .4 LINKS (GONE)  
10" LYNN N 75 W .15 LINKS (GONE)

(Witnesses Continued on Back ...)

B. Description of corner evidence found and/or method applied in restoring or reestablishing corner:  
1/2" I.P 1.4 BELOW MON BOX DIST TO K-10 2636.21'(M), 2635.96'(R) DIST TO L-09 2652.57'(M) 2652.44'(R) CORNER IN CONCRETE ROAD

C. Description of monument for corner and accessories established to perpetuate locating the position of the corner:  
06/21/1995 Wilkerson 21584 O.H.M. Remon  
SET W.C.R. REMON CAP AND WASHER OVER FD. 1/2" IRON PIPE.  
6 S.W. FACE OF P.P. WASHER AND P.K. N 43 W 60.82'  
8 S.W. FACE OF POLE P.K. WASHER S 47 E 72.03'  
9 S.E. FACE P.P. P.K. WASHER S 30 W 81.90'  
10 O.H.M. TAG N 46 E 93.30' WOOD LIGHT POLE

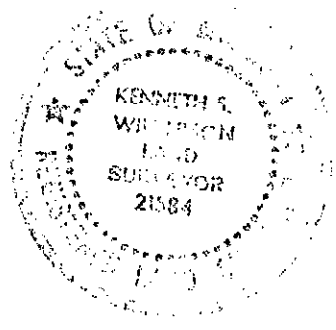

We conclude that after careful study of the record documentation and field observations, that this corner is accepted as the best available evidence of the position of the original corner.

Signed by [Signature]  
Drafted by Kenneth S. Wilkerson  
Surveyor's Michigan License No. 21584

Date Dec 8 1995

Orchard, Hiltz and McCliment, Inc. 34935 Schoolcraft Road Livonia, MI 48150

RECORDED TO ADD PEEB GROUP DATE

\$ 10.00 DEED  
21 DEC 95 9:21 A.M. RECEIPT# 58  
RECORDED  
FOREST E. YOUNGBLOOD, REGISTER OF DEEDS  
WAYNE COUNTY, MI  
\$ 4.00 REMONUMENTATION

Handwritten initials and notes: n/c, oek, [Signature]

96065627  
95273125

96 MAR -7 AM 11:27  
FOREST E. YOUNGBLOOD

A. (Continued) Description of original monument and accessories and/or subsequent restorations:

01/01/1930

B/T

FD IRON

- 1 CULVERT NW 34.23' (GONE)
- 2 CULVERT NE 34.18' (GONE)
- 3 4" ELM SE 60.36' (GONE)
- 4 W.C.R. SIGN POST SW 42.18' (GONE)

LIBER 28477 PAGE 219

03/07/1990

DONNELLY

21563

967

MON IN MON. BOX

- 5 PK WITH RJD TAG IN SE U.P. Az 217 DEG 81.59' (GONE)
- 6 PK WITH RJD TAG IN SW FACE U.P. Az 317 DEG 61.02'
- 7 PK WITH RJD TAG IN NW FACE U.P. Az 43 DEG 73.69'
- 8 PK WITH RJD TAG IN SW FACE U.P. Az 139 DEG 71.93'

LIBER 28647 PAGE 716

FILED DO NOT MAIL

RE-RECORD