

LAND CORNER RECORDATION CERTIFICATE

Filing Requirement of Act 74, Mich. P.A. 1970

K-10 Page 1

L129366PA883

For corners in		Located in:	Romulus	Corner Code	
Wayne					
County					
1. Public Land Survey		T 3 S R 9 E		K-10	
		T _____ R _____		_____	
		T _____ R _____		_____	
		T _____ R _____		_____	
2. Property Controlling in Section	S _____	T _____ R _____		_____	
	S _____	T _____ R _____		_____	
3. Miscellaneous Property in Sec.	S _____	T _____ R _____		_____	
	S _____	T _____ R _____		_____	
4. Lot No. _____, Recorded Plat _____					
5. Private Claims _____					

Compliance with
ACT 345, P.A. 1990

APPROVED ON: 12-16-96 *DBJ*
WAYNE COUNTY REMONUMENTATION
PEER GROUP COMMITTEE
Register of Deeds Stamp and File Number

I, Kenneth S. Wilkerson in a field survey on 02/01/1996 do hereby certify that under requirements of P.A. 74, Michigan P.A. of 1970, the corner points mentioned in lines 1 and 2 above were in conformance with regulations and rules therefore as required in the current manual of survey instructions of the United States Department of the Interior, Bureau of Land Management, or by a decree of a Court of Law and/or that the corner points mentioned in lines 3, 4 and 5 above were in conformance with the rules of the Michigan Board of Land Surveyors or by a Decree of a Court of Law, established, re-established, monumented, re-monumented, recovered, found as expressed below.

NOTE: Not more than 4 corners, all in the same town and range, may be recorded on this certificate.

	A	B	C	D	E	F	G	H	I	J	K	L	M
2	6	5	4	3	2	1							
3													
4	7	8	9	10	11	12							
5													
6	18	17	16	15	14	13							
7													
8	19	20	21	22	23	24							
9													
10	30	29	28	27	26	25							
11													
12	31	32	33	34	35	36							
13													

A. Description of original monument and accessories and/or subsequent restorations:

03/03/1816 Wampler G.L.O. Set post.
10" W. Ash S. 71 E. 4 Links (gone)
10" Lyme N. 75 W. 15 Links (gone)

(Witnesses Continued on Back ...)

B. Description of corner evidence found and/or method applied in restoring or reestablishing corner:

Fd. Mon in asph road in Mon box, middlebelt, Dist to k-11 2630.96(R) 2630.72'(M) and K-09 is = 2636.08'(R) 2636.21'(M)

C. Description of monument for corner and accessories established to perpetuate locating the position of the corner:


(2/01/1996 Wilkerson 21584 O.H.M. Remon
SET WCR CAP AND WASHER OVER FD. MON.
10 S80W FACE OF S. GATE POST 61.55'
12 N40W 4TH FENCE POST N OF GATE 82.44'
13 S60W SET WCR TAG ON N SIDE DE POLE 61.66'
14 S30E TOP OF HYD. 120.05'

\$ 10.00 DEED
30 DEC 96 1:36 P.M. RECEIPT# 44B
RECORDED
FOREST E. YOUNGBLOOD, REGISTER OF DEEDS
WAYNE COUNTY, MI
\$ 4.00 REMONUMENTATION

We conclude that after careful study of the record documentation and field observations, that this corner is accepted as the best available evidence of the position of the original corner.

Signed by *Kenneth S. Wilkerson*
Drafted by Kenneth S. Wilkerson
Surveyor's Michigan License No. 21584
Orchard, Hiltz and McCliment, Inc. 34935 Schoolcraft Road Livonia, MI 48150

Date Dec 26 1996

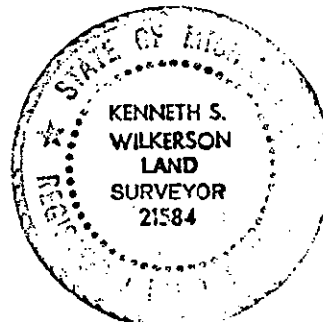

4R
100
DBJ

A. (Continued) Description of original monument and accessories and/or subsequent restorations:

01/01/1930

B/T

Iron

- 1 20" Sycamore N.W. 103.64' (gone)
- 2 6" Elm N.E. 72.55' (gone)
- 3 6" Elm S.E. 32.69' (gone)
- 4 6" ELM S.E. 85.45' (gone)
- 5 W.C.R. Sign Post S.W. 38.55' (gone)

LI29366PA884

05/05/1970

A. Klopskinski

W.C.R.C.

Mon in Mon box

- 6 M.B.T. S.W. 39.62' (gone)
- 7 12" Ash S.W. 85.31' (gone)
- 8 M.B.T. S.W. 81.85' (gone)

12/07/1977

E. GOETZ

W.C.R.C.

CONC. MON. WITH 1/2" :
REBAR 5" DEEP IN MON BOX.

- 9 W.C.R.C. brass tag N.E. of MBT S.E. 34.93' (gone)
- 10 F/ S. post at ground level S.W. 60.80' (R)
- 11 Face of 4th post N.W. 75.95'

12/12/1977

W.C.R.C.

not described

- 9 M.B.T. S.W. 34.92' (gone)
- 10 Face of gate post S.W. 60.78' (R) 61.55' (M)
- 11 Face of 4th fence post N.W. 75.95' (gone)