

**SURVEY &  
REMONUMENTATION**

**RC 1452**

**L127794PA330**

**LAND CORNER RECORDATION CERTIFICATE**

**APR 25 1995**

**Filing Requirement of Act 74, Mich. P.A. 1970**

K-13 Page 1

For corners in **COMMISSION**

Wayne

Located in: Romulus Corner Code

County

- |                                       |                           |               |
|---------------------------------------|---------------------------|---------------|
| 1. Public Land Survey                 | T <u>3</u> S R <u>9</u> E | <u>K-13</u> ✓ |
|                                       | T _____ R _____           | _____         |
|                                       | T <u>4S</u> R <u>9E</u>   | <u>K-01</u>   |
|                                       | T _____ R _____           | _____         |
| 2. Property Controlling<br>In Section | S _____ T _____ R _____   | _____         |
|                                       | S _____ T _____ R _____   | _____         |
| 3. Miscellaneous<br>Property in Sec.  | S _____ T _____ R _____   | _____         |
|                                       | S _____ T _____ R _____   | _____         |
| 4. Lot No. _____, Recorded Plat _____ |                           |               |
| 5. Private Claims _____               |                           |               |

Compliance with  
ACT 345, P.A. 1990

APPROVED ON: 12/9/94 WCD  
WAYNE COUNTY REMONUMENTATION  
PEER GROUP COMMITTEE

Register of Deeds Stamp and File Number

I, Kenneth S. Wilkerson in a field survey on 11/03/1994  
do hereby certify that under requirements of P.A. 74, Michigan P.A. of 1970, the corner points mentioned in lines 1 and 2 above were in conformance with regulations and rules therefore as required in the current manual of survey instructions of the United States Department of the Interior, Bureau of Land Management, or by a decree of a Court of Law and/or that the corner points mentioned in lines 3, 4 and 5 above were in conformance with the rules of the Michigan Board of Land Surveyors or by a Decree of a Court of Law, established, re-established, monumented, re-monumented, recovered, found as expressed below.

**NOTE: Not more than 4 corners, all in the same town and range, may be recorded on this certificate.**

	A	B	C	D	E	F	G	H	I	J	K	L	M
2	8	5	4	3	2	1							
3													
4	7	8	9	10	11	12							
5													
6	18	17	16	15	14	13							
7													
8	19	20	21	22	23	24							
9													
10	30	29	28	27	26	25							
11													
12	31	32	33	34	35	36							
13													

A. Description of original monument and accessories and/or subsequent restorations:

01/01/1816 G.L.O. Set post  
16" W. OAK S 64 E 56 LINKS (36.96') (GONE)  
30" W. OAK N56 E 36 LINKS (23.76') (GONE)

( Witnesses Continued on Back ...)

B. Description of corner evidence found and/or method applied in restoring or reestablishing corner:

Fd. 1" iron rod (1.0' below surface) in mon. box w/cover in asph. pvm't. @ int of cl's of Rds. Dist. to L-13 = 2646.56' (R), 2646.88' (M) & Dist. to K-12, = 2656.17(R), 2655.63' (M)

C. Description of monument for corner and accessories established to perpetuate locating the position of the corner:

11/03/1994 Wilkerson 21584 O.H.M. Remon


- SET W.C.R. WASHER OVER CORNER.
- CORNER COMMON WITH K-1, HURON TWP.
- 8 SET P.K. W/W.C.R. TAG N.E. SIDE U.P. S40E 65.70'
- 9 SET P.K. W/W.C.R. TAG N.W. SIDE N38E 66.20'
- 10 SET P.K. W/W.C.R. TAG S.W. SIDE U.P. N42W 48.70'
- 11 FD. P.K. W/W.C.R.C. BRASS TAG S.E. SIDE U.P. SW 84.65'
- 12 SET P.K. W/W.C.R. TAG S.W. SIDE S30W 87.20'

1995 MICHIGAN LAND RECORDING  
FILED 04 21 1995  
LANSING, MICHIGAN

We conclude that after careful study of the record documentation and field observations, that this corner is accepted as the best available evidence of the position of the original corner.

Signed by [Signature]  
Drafted by Kenneth S. Wilkerson  
Surveyor's Michigan License No. 21584

Date Dec 21 1994

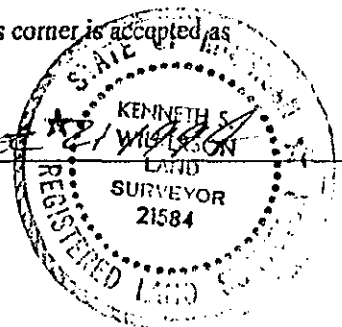

Orchard, Hiltz and McCliment, Inc. 34935 Schoolcraft Road Livonia, MI 48150

## A. (Continued) Description of original monument and accessories and/or subsequent restorations:

01/01/1816		G.L.O.	Set post	
	CORNER COMMON TO HURON TWP.			
01/01/1930		W.C.R.C.	Fd. iron	
1	24" SYCAMORE NE 38.40' (GONE)			
2	24" OAK SE 45.20' (GONE)			
3	FENCE POST SW 49.75' (GONE)			
4	W.C.R. CROSSING SIGN POST NW 39.80' (GONE)			
5	IRON SOUTH 1.32' (GONE)			
13	DIST. TO L-13 = 2646.56'			
14	DIST. TO K-12 = 2656.17'			
11/01/1967		Det. Ed.	Field Notes Huron Twp.	Fd. iron
	NW COR. OF SEC. 1 IS WITNESSED IN D.E. FIELD NOTES			
1	24" SYCAMORE NE 38.40' (GONE)			
2	24" OAK SE 45.20' (GONE)			
3	FENCE POST SW 49.75' (GONE)			
4	W.C.R. CROSSING SIGN POST NW 39.80' (GONE)			
5	IRON SOUTH 1.32' (GONE)			
05/01/1970		W.C.R.C.	Fd. mon	
6	D.E. POLE NW 44.60' (GONE)			
7	22" WALNUT NE 65.85' (GONE)			
8	SIGNAL GUY POLE SE 66.37'			
06/16/1975		W.C.R.C.	Fd. iron pipe in mon. in mon. box	
8	NAIL W/WCRC BRASS TAG NE SIDE ANCHR POLE SE 66.38'			
9	NAIL W/WCRC BRASS TAG NW SIDE D.E. POLE NE 66.59'			
10	NAIL W/WCRC BRASS TAG SW SIDE D.E. POLE NW 47.92'			
11	NAIL W/WCRC BRASS TAG SE SIDE MBT POLE SW 84.65'			

L127794PA331