

**SURVEY &
REMONUMENTATION**

RC 1453

LAND CORNER RECORDATION CERTIFICATE

APR 25 1995

Filing Requirement of Act 74, Mich. P.A. 1970

L127794PA332
M-01 Page 1

For completion by
COMMISSION

Wayne

Located In: Romulus Corner Code

County

- | | | |
|---------------------------------------|---------------------------|-------|
| 1. Public Land Survey | T <u>3</u> S R <u>9</u> E | M-01 |
| | T _____ R _____ | _____ |
| | T _____ R _____ | _____ |
| | T _____ R _____ | _____ |
| 2. Property Controlling In Section | S _____ T _____ R _____ | _____ |
| | S _____ T _____ R _____ | _____ |
| 3. Miscellaneous Property In Sec. | S _____ T _____ R _____ | _____ |
| | S _____ T _____ R _____ | _____ |
| 4. Lot No. _____, Recorded Plat _____ | | |
| 5. Private Claims _____ | | |

Compliance with
ACT 345, P.A. 1990

APPROVED ON: 12/9/94 *NCAR*
WAYNE COUNTY REMONUMENTATION
PEER GROUP COMMITTEE

Register of Deeds Stamp and File Number

I, Kenneth S. Wilkerson in a field survey on 11/03/1994 do hereby certify that under requirements of P.A. 74, Michigan P.A. of 1970, the corner points mentioned in lines 1 and 2 above were in conformance with regulations and rules therefore as required in the current manual of survey instructions of the United States Department of the Interior, Bureau of Land Management, or by a decree of a Court of Law and/or that the corner points mentioned in lines 3, 4 and 5 above were in conformance with the rules of the Michigan Board of Land Surveyors or by a Decree of a Court of Law, established, re-established, monumented, re-monumented, recovered, found as expressed below.

NOTE: Not more than 4 corners, all in the same town and range, may be recorded on this certificate.

	A	B	C	D	E	F	G	H	I	J	K	L	M
2	6		5		4		3		2		1		
3													
4	7		8		9		10		11		12		
5													
6	18		17		16		15		14		13		
7													
8	19		20		21		22		23		24		
9													
10	30		29		28		27		26		25		
11													
12	31		32		33		34		35		36		
13													

A. Description of original monument and accessories and/or subsequent restorations:

01/01/1816 G.L.O. Set post
20" SYC. N 79 W 13 LINKS (8.58') (GONE)
9" BEACH N 10 E 20 LINKS (13.20') (GONE)

(Witnesses Continued on Back ...)

B. Description of corner evidence found and/or method applied in restoring or reestablishing corner:

Fd. 1" iron pipe in mon box (no lid) in pvm't @ int. of cl's of Inkster & VanBorn Rds. Dist. to I-13 T2S, R9E = 2637.52' (R), 2637.31' (M). Dist. to A-2 T3S., R10E., = 2641.59'(R), 2641.47'(M).,

C. Description of monument for corner and accessories established to perpetuate locating the position of the corner:

11/03/1994 Wilkerson 21584 O.H.M. Remon


- CORNER COMMON TO 4 TOWNSHIPS.
S 1/2" I.R. IN 1" I.P. W/W.C.R. WASHER & CAP ON CORNER.
- 8 W.C.R. TAG N.W./S P.P. N 54 E 77.28'
 - 9 W.C.R. TAG E/S P.P. S 43 W 70.33'
 - 10 W.C.R. TAG W/S P.P. N 44 W 61.48'
 - 11 .W. COR. MAIL BOX PAD S43E'
 - 14 ANGLE TO R. B.S. L-1 = 180-14'26"

\$ 16.00 MISCELLANEOUS RECORDING
21 DEC 94 3:23 P.M. RECEIPT# 93A
RECORDED
FOREST E. YOUNGBLOOD, REGISTER OF DEEDS
WAYNE COUNTY, MI

We conclude that after careful study of the record documentation and field observations, that this corner is accepted as the best available evidence of the position of the original corner.

Signed by [Signature]
Drafted by Kenneth S. Wilkerson
Surveyor's Michigan License No. 21584

Date Dec 21 1994

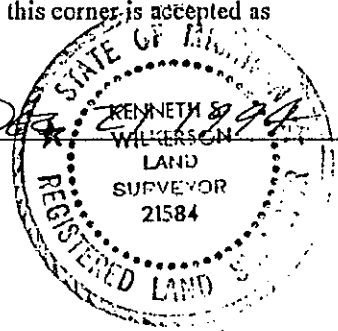

Orchard, Hiltz and McCliment, Inc. 34935 Schoolcraft Road Livonia, MI 48150

ER
14 N 1050

A. (Continued) Description of original monument and accessories and/or subsequent restorations:

01/01/1930	W.C.R.C.	B/T	Fd. iron
1	20" MAPLE NE 108.32' (GONE)		
2	FACE OF SIGN NE 57.20' (GONE)		
3	D.E. POLE NE 69.90' (GONE)		
4	CENTERLINE MANHOLE SE 41.95' (GONE)		
5	D.E. POLE SW 61.30' (GONE)		
6	D.E. POLE NW 54.52' (GONE)		
12	DIST TO L-13 T.2S., R.9E., = 2637.52		
13	DIST TO A-2 T.3S., R.10E., = 2641.59'		
14	ANGLE TO R B.S.L-1 = 180-28'00"		
01/20/1976			
	W.C.R.C.		Fd. 3/4" pipe in 3 1/2" conc.
7	LITE POLE NE 63.22' (GONE)		
8	D.E. POLE NE 77.52'		
9	D.E. POLE SW 70.62'		
10	LITE POLE NW 61.50'		

L127794PA333