

FEB 29 1994

LAND CORNER RECORDATION CERTIFICATE
Filing Requirement of Act 74, Mich. P.A. 1970

L127042PA376

For corners in OCULUS TOWNSHIP

WAYNE

County:

ROMULUS TOWNSHIP #13

Located in:

Corner Code #

- 1. Public Land Survey T 3 S R 9 E M-03
 T _____ R _____
 T _____ R _____
 T _____ R _____
- 2. Property Controlling S _____
 in Section S _____ T _____ R _____
 T _____ R _____
- 3. Miscellaneous S _____
 Property in Sec. S _____ T _____ R _____
 T _____ R _____

Compliance with
ACT 345, P.A. 1990
APPROVED ON: 12-15-93 *P.B.J.*
WAYNE COUNTY REMONUMENTATION
PEER GROUP COMMITTEE

Register of Deeds Stamp & File Number

- 4. Lot No. _____, Recorded Plat _____
- 5. Private Claims _____

I, Kenneth S. Wilkerson, in a field survey on October 28, 19 93
do hereby certify that under requirements of P.A. 74, Michigan P.A. of 1970, the corner points mentioned
in lines 1 and 2 above were in conformance with regulations and rules therefore as required in the current
manual of survey instructions of the United States Department of the Interior, Bureau of Land Management
or by a decree of a Court of Law and/or that the corner points mentioned in lines 3, 4 and 5 above were in
conformance with the rules of the Michigan Board of Land Surveyors or by a Decree of a Court of Law;
established, re-established, monumented, re-monumented, recovered, found as expressed below:

NOTE: Not more than 4 corners, all in the same town and range, may be recorded on this certificate.

A. Description of original monument and accessories and/or subsequent restoration:

- M-03 Set Post - GLO - NO GLO WITNESSES REMAIN
Fd. Iron - B of T
- M-03 Fd. mon. in mon. box, L. 20402, P. 909 - 10/27/77
- NE 71.00 nail in NW face MBT P
- SE 53.30 nail in NE face MBT P
- SW 43.70 WCRC sign post
- W 4.50 & N 0.83 iron
- NW 53.02 nail in SW face PP

B. Description of corner evidence found and/or method applied in restoring or reestablishing corner:

- M-03 Fd. 1/2" rod in mon. box
Per L. 20402, P. 909
- N 29 E 71.00 WCRC tag in W face PP
- S 72 E 54.10 X on bolt base
- S 73 W 47.85 nail in N face guard rail
- N 27 W 50.35 nail in S face MBT P

C. Description of monument for corner and accessories established to perpetuate locating the position of the corner:

- Set WC remonumentation washer and OHM KSW 21584 cap on iron.
- M-03 045 AZ 73.49 WCRC tag in SE face PP
- 136 AZ 55.84 NE bolt in sign base
- 244 AZ 66.45 WCRC tag in SE face PP
- 317 AZ 65.86 WCRC tag in NE face PP

The selected location is accepted as the best evidence of the original corner.

Signed by: *Kenneth S. Wilkerson*


Date: Nov 30 1993

Drafted By: Kenneth S. Wilkerson
Surveyor's Michigan License No. 21584

Orchard, Hiltz & McCliment, Inc.
34935 Schoolcraft Road * Livonia, Michigan 48150 * Phone: (313) 522-6711

A	B	C	D	E	F	G	H	I	J	K	L	M
2	6	5	4	3	2	1						
3												
4	7	8	9	10	11	12						
5												
6	18	17	16	15	14	13						
7												
8	19	20	21	22	23	24						
9												
10	30	29	28	27	26	25						
11												
12	31	32	33	34	35	36						
13												

93 DEC 15 PM 5:00
FORESTER YOUNGELOOD
REGISTER OF DEEDS
WAYNE COUNTY, MI

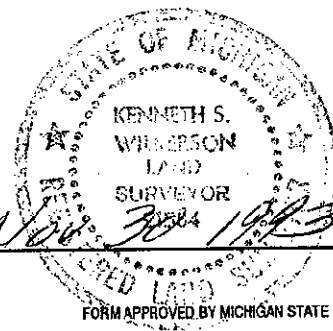

2R
11K1