

**SURVEY &
REMONUMENTATION**

RC 1454

LAND CORNER RECORDATION CERTIFICATE

L127794PA334

APR 25 1995

Filing Requirement of Act 74, Mich. P.A. 1970

M-05 Page 1

For certificate by **COMMISSION**

Wayne

Located in: Romulus Corner Code _____

County _____

- | | | |
|---------------------------------------|---------------------------------------|-------|
| 1. Public Land Survey | T <u>3</u> S _____ R <u>9</u> E _____ | M-05 |
| | T _____ R _____ | _____ |
| | T _____ R _____ | _____ |
| | T _____ R _____ | _____ |
| 2. Property Controlling In Section | S _____ T _____ R _____ | _____ |
| | S _____ T _____ R _____ | _____ |
| 3. Miscellaneous Property In Sec. | S _____ T _____ R _____ | _____ |
| | S _____ T _____ R _____ | _____ |
| 4. Lot No. _____, Recorded Plat _____ | | |
| 5. Private Claims _____ | | |

Compliance with
ACT 345, P.A. 1990

APPROVED ON: 12/9/94 WCKD
WAYNE COUNTY REMONUMENTATION
PEER GROUP COMMITTEE

Register of Deeds Stamp and File Number

I, Kenneth S. Wilkerson in a field survey on 11/02/1994
do hereby certify that under requirements of P.A. 74, Michigan P.A. of 1970, the corner points mentioned in lines 1 and 2 above were in conformance with regulations and rules therefore as required in the current manual of survey instructions of the United States Department of the Interior, Bureau of Land Management, or by a decree of a Court of Law and/or that the corner points mentioned in lines 3, 4 and 5 above were in conformance with the rules of the Michigan Board of Land Surveyors or by a Decree of a Court of Law, established, re-established, monumented, re-monumented, recovered, found as expressed below.

NOTE: Not more than 4 corners, all in the same town and range, may be recorded on this certificate.

	A	B	C	D	E	F	G	H	I	J	K	L	M
2	8	5	4	3	2	1							
3													
4	7	8	9	10	11	12							
5													
6	18	17	16	15	14	13							
7													
8	19	20	21	22	23	24							
9													
10	30	29	28	27	26	25							
11													
12	31	32	33	34	35	36							
13													

A. Description of original monument and accessories and/or subsequent restorations:

01/01/1816 G.L.O. Set post
12" W. OAK NORTH 5.23 (GONE)
9" POPLAR N 61 W 32 LINKS (21.12') (GONE)

(Witnesses Continued on Back ...)

B. Description of corner evidence found and/or method applied in restoring or reestablishing corner:

Fd. 1/2" iron rod (badly bent) in mon. box (no lid) in conc. pav't. @ int. of cl's Wick & Inkster Rds

C. Description of monument for corner and accessories established to perpetuate locating the position of the corner:

11/02/1994 Wilkerson 21584 O.H.M. Remon


- SET W.C.R. WASHER & CAP ON CORNER.
2 FD. MON BOX (N.W. COR. SEC. 18, TAYLOR) NORTH 2.85'
7 W.C.R. TAG W/S P.P. N 41 E 75.48'
8 W.C.R. TAG N/S P.P. S 33 E 58.12'
9 W.C.R. TAG N/S P.P. S 51 W 75.97'
14 DISTANCE TO L-05 = 2728.63'
15 W.C.R. TAG E/S P.P. N 50 W 78.34'

\$ 16.00 MISCELLANEOUS RECORDING
21 DEC 94 3:23 P.M. RECEIPT# 93A
RECORDED
FOREST E. YOUNGBLOOD, REGISTER OF DEEDS
WAYNE COUNTY, MI

We conclude that after careful study of the record documentation and field observations, that this corner is accepted as the best available evidence of the position of the original corner.

Signed by [Signature]
Drafted by Kenneth S. Wilkerson
Surveyor's Michigan License No. 21584

Date DEC 21 1994

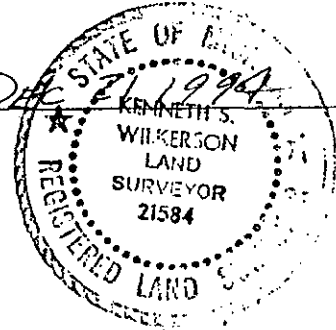

Orchard, Hiltz and McCliment, Inc. 34935 Schoolcraft Road Livonia, MI 48150

Z R
14 N - 10150

A. (Continued) Description of original monument and accessories and/or subsequent restorations:

01/01/1930	W.C.R.C.		Fd. iron over stone	
1	W.C.R. SIGN POST NE 32.17' (GONE)			
2	STONE NORTH 3.39'			
3	TEL. POLE SE 36.07' (GONE)			
4	24" MAPLE SW 35.30' (GONE)			
5	30" MAPLE SW 77.40' (GONE)			
6	28" MAPLE NW 35.40' (GONE)			
14	DIST = 2728.07' TO L-05			
05/05/1970	W.C.R.C.		Fd. iron in mon. box	
2	MON. TAYLOR SEC. 18 NORTH 2.85'			
7	D.E. POLE NE 76.14'			
8	D.E. POLE SE 58.68'			
9	D.E. POLE SW 76.52'			
10	D.E. POLE NW 79.27' (GONE)			
08/21/1972	Carlson	14759	R.C.1	Fd. iron bar in Mon. box
2	N.W. COR. SEC. 18, TAYLOR NORTHERLY 2.83'			
9	P.K. NAIL IN POLE S 50 W 76.50'			
11	P.K. NAIL IN POLE N 48 W 78.30'			
12	P.K. NAIL IN POLE S 46 E 70.50' (GONE)			
12/21/1977	Parish	24609	R.C.6	Fd. mon. box
2	MON. BOX NORTH 2.8'			
9	P.K. NAIL WITH CAP IN WOOD POLE S 35 W 76.7'			
13	P.K. NAIL WITH CAP IN WOOD POLE S35E 71.25' (GONE)			

L127794PA335