

LAND CORNER RECORDATION CERTIFICATE

APR 05 1996

Filing Requirement of Act 74, Mich. P.A. 1970

M-06 Page 1

For corners in COMMISSION

LIBER 28647 PAGE 711

Wayne	Located in:	Romulus	Corner Code	
County				
1. Public Land Survey	T 3 S R 9 E		M-06	
	T	R		
	T	R		
	T	R		
2. Property Controlling in Section	S	T	R	
	S	T	R	
3. Miscellaneous Property in Sec.	S	T	R	
	S	T	R	
4. Lot No. _____, Recorded Plat _____				
5. Private Claims _____				

Compliance with ACT 345, P.A. 1990

APPROVED ON: 11-30-95 [Signature]

WAYNE COUNTY REMONUMENTATION

Register of Deeds Stamp and File Number

A	B	C	D	E	F	G	H	I	J	K	L	M
2	6	5	4	3	2	1						
3												
4	7	8	9	10	11	12						
5												
6	18	17	16	15	14	13						
7												
8	19	20	21	22	23	24						
9												
10	30	29	28	27	26	25						
11												
12	31	32	33	34	35	36						
13												

I, Kenneth S. Wilkerson in a field survey on 11/21/1995 do hereby certify that under requirements of P.A. 74, Michigan P.A. of 1970, the corner points mentioned in lines 1 and 2 above were in conformance with regulations and rules therefore as required in the current manual of survey instructions of the United States Department of the Interior, Bureau of Land Management, or by a decree of a Court of Law and/or that the corner points mentioned in lines 3, 4 and 5 above were in conformance with the rules of the Michigan Board of Land Surveyors or by a Decree of a Court of Law, established, re-established, monumented, re-monumented, recovered, found as expressed below.

NOTE: Not more than 4 corners, all in the same town and range, may be recorded on this certificate.


A. Description of original monument and accessories and/or subsequent restorations:  
 02/05/1817 G.L.O. SET POST  
 6" POPLAR S27E 80 CHAINS  
 11" POPLAR S42E 82 CHAINS

(Witnesses Continued on Back ...)

B. Description of corner evidence found and/or method applied in restoring or reestablishing corner:  
 FD. CONC. MON. WITH 1/4 IRON ROD IN MON. BOX 5" BELOW THE PAVED ROAD. DIST. TO M-5=2638.04(R) 2638.32'(M), DIST. TO M-7=2638.86'(R) 2639.36'(M)

C. Description of monument for corner and accessories established to perpetuate localing the position of the corner:  
 11/21/1995 WILKERSON 21584 O.H.M. REMON  
 SET W.C.R. CAP OVER FD. CONC. MON. RAISED MON.  
 CORNER IS NOT COMMON WITH SECTION TO THE EAST.  
 1 FD. IRON NORTH 19.71'  
 8 W.C.R. WITNESS TAG M.B.T. POLE S50E 69.86'  
 12 W.C.R.C. WITNESS TAG NE FACE WOOD GUY POLE N45E 42.79'  
 13 W.C.R.C. NAIL IN NE FACE DE POLE N45E 69.84'

\$ 10.00 DEED  
 21 DEC 95 9:21 A.M. RECEIPT# 5B  
 RECORDED  
 FOREST E. YOUNGBLOOD, REGISTER OF DEEDS  
 WAYNE COUNTY, MI  
 \$ 4.00 REMONUMENTATION

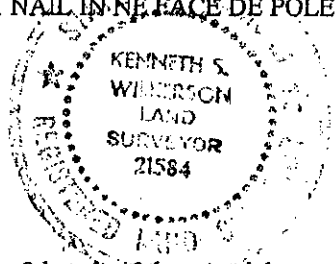

We conclude that after careful study of the record documentation and field observations, that this corner is accepted as the best available evidence of the position of the original corner.

Signed by [Signature]  
 Drafted by Kenneth S. Wilkerson  
 Surveyor's Michigan License No. 21584

Date Dec 8 1995

Orchard, Hiltz and McCliment, Inc. 34935 Schoolcraft Road Livonia, MI 48150

RECORD TO ADD BEER GROUP DATE

Mc  
per  
J.C.  
[Handwritten initials]

A. (Continued) Description of original monument and accessories and/or subsequent restorations:

05/05/1930

WAYNE CO.  
W.P.A.

SET IRON

- 1 IRON (E-1 TAYLOR) NORTH 19.83'
- 2 FP NE 38.83' (GONE)
- 3 CLUMP OF BASSWOODS SW 49.01' (GONE)
- 4 4" TWIN ELM SW 48.21' (GONE)
- 5 CROSSCUT ON CULVERT WEST 27.74' (GONE)
- 6 W.C.R. SIGN POST NW 53.63' (GONE)

LIBER 28477 PAGE 223

LIBER 28647 PAGE 712

05/05/1970

W.C.R.C.

MON. IN BOX

- 1 IRON NORTH 19.70'
- 7 MBT NE 137.32' (GONE)
- 8 MBT SE 69.90'
- 9 ASH CLUMP SW 62.87' (GONE)

08/21/1972

CARLSON

14759

143

FD. IRON BAR IN MON. BOX,  
WITH STEEL COVER

- 1 IRON NORTH 19.80'
- 8 P.K. NAIL IN POLE S25E 69.55'
- 10 6" STEEL POST N71W 39.95'
- 11 WOOD GUARD POST S17W 56.30' (GONE)