

**SURVEY &  
REMONUMENTATION**

**RC 1455**

**LI27794PA336**

**APR 25 1995**

**LAND CORNER RECORDATION CERTIFICATE**

**Filing Requirement of Act 74, Mich. P.A. 1970**

M-07 Page 1

**COMMISSION**

For corners in

Wayne

Located in: Romulus Corner Code

County

- |                                       |         |              |              |             |
|---------------------------------------|---------|--------------|--------------|-------------|
| 1. Public Land Survey                 |         | T <u>3</u> S | R <u>9</u> E | <u>M-07</u> |
|                                       |         | T _____      | R _____      | _____       |
|                                       |         | T _____      | R _____      | _____       |
|                                       |         | T _____      | R _____      | _____       |
| 2. Property Controlling<br>in Section | S _____ | T _____      | R _____      | _____       |
|                                       | S _____ | T _____      | R _____      | _____       |
| 3. Miscellaneous<br>Property in Sec.  | S _____ | T _____      | R _____      | _____       |
|                                       | S _____ | T _____      | R _____      | _____       |
| 4. Lot No. _____, Recorded Plat _____ |         |              |              |             |
| 5. Private Claims _____               |         |              |              |             |

Compliance with  
ACT 345, P.A. 1990

APPROVED ON: 12/9/94 JCO  
WAYNE COUNTY REMONUMENTATION  
PEER GROUP COMMITTEE

Register of Deeds Stamp and File Number

	A	B	C	D	E	F	G	H	I	J	K	L	I
2	6	5	4	3	2	1							
3													
4	7	8	9	10	11	12							
5													
6	18	17	16	15	14	13							
7													
8	19	20	21	22	23	24							
9													
10	30	29	28	27	26	25							
11													
12	31	32	33	34	35	36							
13													

I, Kenneth S. Wilkerson in a field survey on 11/02/1994  
do hereby certify that under requirements of P.A. 74, Michigan P.A. of 1970, the corner points mentioned in lines 1 and 2 above were in conformance with regulations and rules therefore as required in the current manual of survey instructions of the United States Department of the Interior, Bureau of Land Management, or by a decree of a Court of Law and/or that the corner points mentioned in lines 3, 4 and 5 above were in conformance with the rules of the Michigan Board of Land Surveyors or by a Decree of a Court of Law, established, re-established, monumented, re-monumented, recovered, found as expressed below.

**NOTE: Not more than 4 corners, all in the same town and range, may be recorded on this certificate.**

**A. Description of original monument and accessories and/or subsequent restorations:**

01/01/1816 Wampler G.L.O. Set post  
6" B. ASH N 15 W 12 LINKS (7.92')  
9" ELM N 76 W 7 LINKS (4.62')

(Witnesses Continued on Back ...)

**B. Description of corner evidence found and/or method applied in restoring or reestablishing corner:**

SET 1/2" I.R. WITH MON. BOX USING WAYNE CO SEC. TIES DIST. TO M-08 = 2642.98' (R),  
2642.93' (M) CORNER TO N. = 40.65 (R), 40.67' (M), ANGLE 91-01'45" (R) 91-01'35" (M)

**C. Description of monument for corner and accessories established to perpetuate locating the position of the corner:**


11/02/1994 Wilkerson 21584 O.H.M. Remon  
SET W.C.R. WASHER & CAP ON CORNER (1/2" IRON IN MON BOX)  
14 W.C.R. TAG SW SIDE P.P. N35W 112.84'  
15 TOP BOLT ON LIGHT POLE N50E 103.84'  
16 TOP BOLT ON HYD. S75E 103.84'  
17 N.E. COR. BLG. #27409 S65W 91.23'

\$ 16.00 MISCELLANEOUS RECORDING  
21 DEC 94 3:23 P.M. RECEIPT# 93A  
RECORDED  
FOREST E. YOUNGBLOOD, REGISTER OF DEED  
WAYNE COUNTY, MI

We conclude that after careful study of the record documentation and field observations, that this corner is accepted as the best available evidence of the position of the original corner.

Signed by [Signature]  
Drafted by Kenneth S. Wilkerson  
Surveyor's Michigan License No. 21584  
Orchard, Hiltz and McCliment, Inc. 34935 Schoolcraft Road Livonia, MI 48150

Date Dec 21 1994

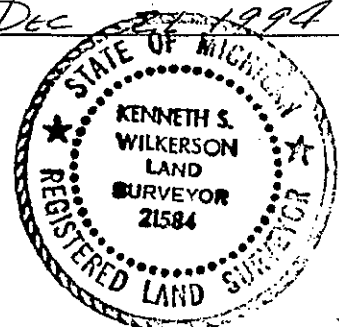

ER  
14-N 1415

A (Continued) Description of original monument and accessories and/or subsequent restorations:

01/01/1930 Wayne Co. B/T Fd. iron

- 1 CROSS ON W.C.R. SIGN POST NORTHWESTERLY 73.16'
- 2 MON. NORTHWESTERLY 81.77'
- 3 IRON NORTHERLY 40.73'
- 4 TEL. POLE NORTHEASTERLY 28.85'
- 5 MON. SOUTHEASTERLY 51.48'
- 6 MON. SOUTHWESTERLY 52.78'
- 9 DIST = 2642.98' TO M-08
- 10 DIST = 2737.62' TO L-07
- 11 DIST = 2638.86' TO M-06
- 12 BS) M-08 FS) L-07 ANGLE = 91-01-45
- 13 BS) L-07 FS) M-06 ANGLE = 89-26-50

LI27794PA337

05/05/1970 Wayne Co. Rd. Mon.  
Comm.

- 3 IRON NORTHERLY 40.65'
- 7 ED. POLE NORTHWESTERLY 113.38'
- 8 ED. POLE NORTHEASTERLY 36.00'