

SURVEY &
RECORDS

RC 1355

LAND CORNER RECORDATION CERTIFICATE
Filing Requirement of Act 74, Mich. P.A. 1970

L127042PA377

For corners in

WAYNE
County:
ROMULUS TOWNSHIP #13

Located in: _____ Corner Code # _____

1. Public Land Survey T 3 S R 9 E M-09
T _____ R _____
T _____ R _____
T _____ R _____

2. Property Controlling S _____ T _____
in Section S _____ T _____ R _____

3. Miscellaneous S _____ T _____
Property in Sec. S _____ T _____ R _____

4. Lot No. _____, Recorded Plat _____

5. Private Claims _____

Compliance with
ACT 345, P.A. 1990
APPROVED ON: 12-13-93
WAYNE COUNTY REMONUMENTATION
PEER GROUP COMMITTEE

Register of Deeds Stamp & File Number

RC 1355

I, Kenneth S. Wilkerson, in a field survey on October 28, 19 93, do hereby certify that under requirements of P.A. 74, Michigan P.A. of 1970, the corner points mentioned in lines 1 and 2 above were in conformance with regulations and rules therefore as required in the current manual of survey instructions of the United States Department of the Interior, Bureau of Land Management or by a decree of a Court of Law and/or that the corner points mentioned in lines 3, 4 and 5 above were in conformance with the rules of the Michigan Board of Land Surveyors or by a Decree of a Court of Law; established, re-established, monumented, re-monumented, recovered, found as expressed below:

NOTE: Not more than 4 corners, all in the same town and range, may be recorded on this certificate.

A. Description of original monument and accessories and/or subsequent restoration:

M-09 Set Post - GLO - NO GLO WITNESSES REMAIN
Fd. Iron - B of T
Fd. Mon. in Mon. Box, L. 20467, P. 597 - 03/17/79

N 79.77 iron
NE 104.77 nail in SE face 18" elm
NE 81.82 nail in N face PP
SE 52.30 nail in SW face 8" ash
SW 56.92 nail in SE face PP
NW 57.99 mon.

B. Description of corner evidence found and/or method applied in restoring or reestablishing corner:

M-09 Fd. mon. in mon. box per L. 20467, P. 597

N 50 E 54.90 tag in NW face PP
N 70 E 30.24 top of hyd.
S 15 E 102.68 Wedge of sign post
S 45 W 56.49 PK in SE face of PP

C. Description of monument for corner and accessories established to perpetuate locating the position of the corner:

Set WC remonumentation washer and OHM KSW 21584 cap on iron.

M-09 N 80.13 Mon. in Mon. Box
073 AZ 49.85 Top nut on hyd.
255 AZ 43.23 OHM tag in N face PP
399 AZ 106.13 OHM tag in NE face PP


The selected location is accepted as the best evidence of the original corner.

A	B	C	D	E	F	G	H	I	J	K	L	M
2	6	5	4	3	2	1						
3												
4	7	8	9	10	11	12						
5												
6	18	17	16	15	14	13						
7												
8	19	20	21	22	23	24						
9												
10	30	29	28	27	26	25						
11												
12	31	32	33	34	35	36						
13												

93 DEC 15 PM 5:00
FOREST E. YOUNGBLOOD
REGISTER OF DEEDS
WAYNE COUNTY, MI

Signed by: [Signature]

Date: Nov 30 1993

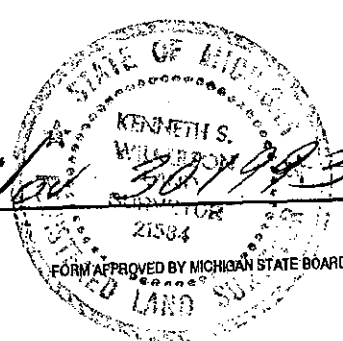

Drafted By: Kenneth S. Wilkerson
Surveyor's Michigan License No. 21584

Orchard, Hiltz & McCliment, Inc.
34935 Schoolcraft Road * Livonia, Michigan 48150 * Phone: (313) 522-6711

FORM APPROVED BY MICHIGAN STATE BOARD OF LAND SURVEYORS, JAN. 28, 1971
REVISED MAY 14, 1975
REVISED JAN., 1983

22
11K1