

SURVEY & REMONUMENTATION

RC 1456

APR 25 1995

LAND CORNER RECORDATION CERTIFICATE

L127794PA338

Filing Requirement of Act 74, Mich. P.A. 1970

COMMISSION

M-11 Page 1

For corners in

Wayne

Located in: Romulus Corner Code

County

- | | | |
|---------------------------------------|---------------------------|-------|
| 1. Public Land Survey | T <u>3</u> S R <u>9</u> E | M-11 |
| | T _____ R _____ | _____ |
| | T _____ R _____ | _____ |
| | T _____ R _____ | _____ |
| 2. Property Controlling In Section | S _____ T _____ R _____ | _____ |
| | S _____ T _____ R _____ | _____ |
| 3. Miscellaneous Property In Sec. | S _____ T _____ R _____ | _____ |
| | S _____ T _____ R _____ | _____ |
| 4. Lot No. _____, Recorded Plat _____ | | |
| 5. Private Claims _____ | | |

Compliance with ACT 345, P.A. 1990

APPROVED ON: 12/9/94 YCAO
WAYNE COUNTY REMONUMENTATION
PEER GROUP COMMITTEE

Register of Deeds Stamp and File Number

I, Kenneth S. Wilkerson in a field survey on 05/03/1994 do hereby certify that under requirements of P.A. 74, Michigan P.A. of 1970, the corner points mentioned in lines 1 and 2 above were in conformance with regulations and rules therefore as required in the current manual of survey instructions of the United States Department of the Interior, Bureau of Land Management, or by a decree of a Court of Law and/or that the corner points mentioned in lines 3, 4 and 5 above were in conformance with the rules of the Michigan Board of Land Surveyors or by a Decree of a Court of Law, established, re-established, monumented, re-monumented, recovered, found as expressed below.

NOTE: Not more than 4 corners, all in the same town and range, may be recorded on this certificate.

	A	B	C	D	E	F	G	H	I	J	K	L	M
2	6	5	4	3	2	1							
3													
4	7	8	9	10	11	12							
5													
6	18	17	16	15	14	13							
7													
8	19	20	21	22	23	24							
9													
10	30	29	28	27	26	25							
11													
12	31	32	33	34	35	36							
13													

A. Description of original monument and accessories and/or subsequent restorations:

01/01/1816 Wampler G.L.O. Set post
10" B. O. S 19 W 1.94 LINKS (1.28') (GONE)
9" B. O. S 54 W 1.5 LINKS (0.99') (GONE)

(Witnesses Continued on Back ...)

B. Description of corner evidence found and/or method applied in restoring or reestablishing corner:

Fd. 1/2" iron pipe in a mon. box. In conc. pave. Dist. to M-12 = 2703.99' (R), 2703.76' (M) & Dist. to L11 = 2623.00' (R), 2623.24' (M)

C. Description of monument for corner and accessories established to perpetuate locating the position of the corner:

05/03/1994 Wilkerson 21584 O.H.M. Remon

SET W.C.R. WASHER AND CAP OVER CORNER
CORNER IS COMMON TO 4 TOWNSHIPS


- 6 SET P.K. W/W.C.R. TAG IN U.P. N60E 83.30'
- 7 SET P.K. W/W.C.R. TAG IN U.P. S25E 49.90'
- 8 SET P.K. W/W.C.R. TAG N28W 59.30'
- 13 SET P.K. WITH W.C.R. TAG IN U.P. N20E 127.60'
- 14 ANGLE TO R. B.S. K-13 = 90-01'40"

\$ 16.00 MISCELLANEOUS RECORDING
21 DEC 94 3:24 P.M. RECEIPT# 93A
RECORDED
FOREST E. YOUNGBLOOD, REGISTER OF DEEDS
WAYNE COUNTY, MI

We conclude that after careful study of the record documentation and field observations, that this corner is accepted as the best available evidence of the position of the original corner.

Signed by [Signature]
Drafted by Kenneth S. Wilkerson
Surveyor's Michigan License No. 21584

Date

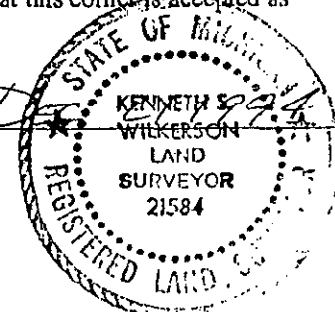

Orchard, Hiltz and McCliment, Inc. 34935 Schoolcraft Road Livonia, MI 48150

ZR
14 N. Misc

A (Continued) Description of original monument and accessories and/or subsequent restorations:

01/01/1930	Wayne Co. B/T	Set iron
1	IRON NORTH 36.80' (A-11, T.3S., R10E.)	
2	ED. POLE NORTHEASTERLY 115.72' (GONE)	
3	36" POPLAR SOUTHEASTERLY 91.40' (GONE)	
4	N.E. COR. OF STORE SOUTHWESTERLY 95.18' (GONE)	
5	ED. POLE NORTHWESTERLY 76.00' (GONE)	
14	DIST. TO M-12 = 2703.99'	
15	DIST. TO L-11 = 2623.00'	
16	ANGLE TO R. B.S. M-12, F.S. L-11 = 90-02'30"	
03/25/1975	Wayne Co. Rd. Comm.	Fd. 3/8" iron pin in mon.
1	IRON NORTH 36.79' (N.W. COR. SEC.1 TAYLOR)	
6	"X" CUT IN TOP OF LIGHT BASE S.E. 67.10' (GONE)	
7	N.E. COR. STORE S.W. 78.89' (GONE)	
8	"X" CUT IN RIM W. SIDE SAN. MH N.W. 70.55' (GONE)	
12/12/1975	Wayne Co. Rd. Comm.	Fd. iron in mon. box
1	IRON NORTH 36.80'	
7	N.E. COR BUILDING S.W. 78.90' (GONE)	
9	BRASS TAG ON N.E. SIDE OF DE POLE N.W. 79.58'	
10	BRASS TAG ON N.E. SIDE OF SIGNAL POLE S.E. 45.96'	
03/15/1976	Swanson 9748 W.C.R.C. L.193	Concrete mon. in box
1	IRON NORTH 36.80'	
7	N.E. COR BUILDING S.W. 78.90' (GONE)	
9	BRASS TAG ON N.E. SIDE OF DE POLE N.W. 79.58'	
10	BRASS TAG ON N.E. SIDE OF SIGNAL POLE S.E. 45.96'	
06/26/1978	Arthurs 11358 L.202	Fd. W.C.R.C.handhole mon.
9	BRASS TAG ON N.E. SIDE OF DE POLE N.W. 79.57'	
10	BRASS TAG ON N.E. SIDE OF SIGNAL POLE S.E. 45.90'	
11	EDGE OF FRAME OF SAN. SEWER MH S.W. 95.90'	

L127794PA339