

LAND CORNER RECORDATION CERTIFICATE

Filing Requirement of Act 74, Mich. P.A. 1970

M-12 Page 1

For corners in

Wayne

Located in: Romulus Corner Code

County

LI29366PA887

1. Public Land Survey		T <u>3</u> S <u>9</u> R <u>9</u> E	<u>M-12</u>
		T _____ R _____	_____
		T _____ R _____	_____
		T _____ R _____	_____
2. Property Controlling in Section	S _____	T _____ R _____	_____
	S _____	T _____ R _____	_____
3. Miscellaneous Property in Sec.	S _____	T _____ R _____	_____
	S _____	T _____ R _____	_____

Compliance with
ACT 345, P.A. 1990

APPROVED ON: 12-16-96 *RSJ*
WAYNE COUNTY REMONUMENTATION
PEER GROUP COMMITTEE

Register of Deeds Stamp and File Number

4. Lot No. _____, Recorded Plat _____
5. Private Claims _____

A B C D E F G H I J K L M

2	6	5	4	3	2	1								
3														
4	7	8	9	10	11	12								
5														
6	18	17	16	15	14	13								
7														
8	19	20	21	22	23	24								
9														
10	30	29	28	27	26	25								
11														
12	31	32	33	34	35	36								
13														

I, Kenneth S. Wilkerson in a field survey on 02/15/1996
do hereby certify that under requirements of P.A. 74, Michigan P.A. of 1970, the corner points mentioned in lines 1 and 2 above were in conformance with regulations and rules therefore as required in the current manual of survey instructions of the United States Department of the Interior, Bureau of Land Management. or by a decree of a Court of Law and/or that the corner points mentioned in lines 3, 4 and 5 above were in conformance with the rules of the Michigan Board of Land Surveyors or by a Decree of a Court of Law, established, re-established, monumented, re-monumented, recovered, found as expressed below.

NOTE: Not more than 4 corners, all in the same town and range, may be recorded on this certificate.

A. Description of original monument and accessories and/or subsequent restorations:

01/01/1816 G.L.O. Set post.
12" W.O. S. 81 W. 3.97 Links (gone)
12" B.O. N. 84 W. 4.9 Links (gone)

(Witnesses Continued on Back ...)

B. Description of corner evidence found and/or method applied in restoring or reestablishing corner:

Fd. 1/2" iron rod in mon. box in asph. Inkster Road., dist. to M-13 = 2633.09' (R), 2632.74' (M); to M-11 = 2703.99' (R) 2703.76'(M)


C. Description of monument for corner and accessories established to perpetuate locating the position of the corner:

02/15/1996 Wilkerson 21584 O.H.M. Remon
NOT A COMMON CORNER
SET WCR CAP ON 1/2" IRON ROD
8 N 88 E O.H.M. TAG ON N SIDE DE POLE 26.58'
13 N 89 W PK NAIL S. SIDE DE POLE 65.35'
14 N 75 E CORNER HOUSE # 27270 89.23'
15 S 30 E EDGE OF FRAME OF GATE VALVE 63.20' (M) 63.36' (R)
18 N 25 W C.L. HYD. 121.55'
19 N 10 W NAIL ON E. SIDE DE POLE 155.47'

\$ 4.00 REMONUMENTATION
\$ 10.00 DEED
30 DEC 96 1:37 P.M. RECEIPT# 44B
RECORDED
FOREST E. YOUNGBLOOD, REGISTER OF DEEDS
WAYNE COUNTY, MI

We conclude that after careful study of the record documentation and field observations, that this corner is accepted as the best available evidence of the position of the original corner.

Signed by *Kenneth S. Wilkerson*
Drafted by Kenneth S. Wilkerson
Surveyor's Michigan License No. 21584
Orchard, Hiltz and McCliment, Inc. 34935 Schoolcraft Road Livonia, MI 48150

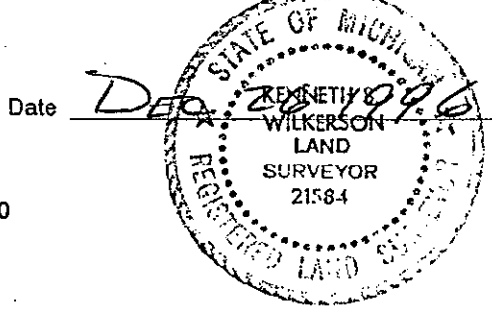

*4R
100
RSJ*

A. (Continued) Description of original monument and accessories and/or subsequent restorations:

01/01/1930	B/T	Iron
1	8" Oak N. E. 78.06' (gone)	
2	4" Oak N.E. 62.72' (gone)	
3	10" Oak S.E. 33.97' (gone)	
4	MON. S.E. 44.85' (gone)	
5	10" Oak S.E. 78.17' (gone)	
6	8" Oak S.W. 34.00' (gone)	
7	Iron W. 33.05' (gone)	
05/01/1970	Klopskinske	W.C.R.C.
8	M.B.T. E. 26.57' (R) 26.58' (M)	Mon. in mon. box
9	14" Maple S.E. 93.83' (gone)	
10	M.B.T. N.W. 155.47' (gone)	
06/24/1974	Roskelly	
8	P.K. nail in pole N. 85 E. 25.23' (R) 26.58' (M)	Mon. in mon. box
9	P.K. nail in 12" Twin Oak S. 20 E. 93.80' (gone)	
16	N.E. corner store S. 60 W. 78.90' (gone)	
17	P.K. nail in pole N. 20 W. 76.75' (gone)	
18	Center hyd. N 25 W 121.55' (gone)	
03/01/1976		W.C.R.C.
8	P.K. M.B.T. N. E. 26.57' (R) 26.58' (M)	Mon. in mon. box
9	Twin 8" and 9" Oak S.E. 93.83' (gone)	
11	C.L. S.W. bolt Fd. for light S.E. 65.40' (gone)	
12	N.E. cor C.B. frame S.W. 34.55' (gone)	
13	P.K. M.B.T. N.W. 65.33' (R) 65.35' (R)	
06/23/1978	B. Arthurs	
8	Nail in S. side Utl. pole N.E. 26.58' (R&M)	
9	Nail in W. side of twin 12" Oak S.E. 93.82' (gone)	
13	W.C.R.C. MON. W. 65.35' (gone)	
14	S.W. cor. house 27270 N.E. 89.23' (R&M)	
15	Edge of frame of GW S. E. 63.36' (R) 63.20' (M)	

LI 29366 PA 888