

**SURVEY &
REMONUMENTATION**

RC 1457

LAND CORNER RECORDATION CERTIFICATE

L127794PA340

APR 25 1995

Filing Requirement of Act 74, Mich. P.A. 1970

M-13 Page 1

For corners in **COMMISSION**

Wayne	Located in:	Romulus	Corner Code	
County				
1. Public Land Survey	T <u>3</u> S	R <u>9</u> E		M-13
	T _____	R _____		
	T _____	R _____		
	T _____	R _____		
2. Property Controlling in Section	S _____	T _____	R _____	
	S _____	T _____	R _____	
3. Miscellaneous Property in Sec.	S _____	T _____	R _____	
	S _____	T _____	R _____	
4. Lot No. _____, Recorded Plat _____				
5. Private Claims _____				

Compliance with
ACT 345, P.A. 1990

APPROVED ON: 12/9/94 7160
WAYNE COUNTY REMONUMENTATION
PEER GROUP COMMITTEE

Register of Deeds Stamp and File Number

I, Kenneth S. Wilkerson in a field survey on 11/01/1994 do hereby certify that under requirements of P.A. 74, Michigan P.A. of 1970, the corner points mentioned in lines 1 and 2 above were in conformance with regulations and rules therefore as required in the current manual of survey instructions of the United States Department of the Interior, Bureau of Land Management, or by a decree of a Court of Law and/or that the corner points mentioned in lines 3, 4 and 5 above were in conformance with the rules of the Michigan Board of Land Surveyors or by a Decree of a Court of Law, established, re-established, monumented, re-monumented, recovered, found as expressed below.

NOTE: Not more than 4 corners, all in the same town and range, may be recorded on this certificate.

	A	B	C	D	E	F	G	H	I	J	K	L	M
2	6	5	4	3	2	1							
3													
4	7	8	9	10	11	12							
5													
6	18	17	16	15	14	13							
7													
8	19	20	21	22	23	24							
9													
10	30	29	28	27	26	25							
11													
12	31	32	33	34	35	36							
13													

A. Description of original monument and accessories and/or subsequent restorations:

01/01/1816 Wampler G.L.O. Set post
14" W.O. N 71 E 127 LINKS (83.82') (GONE)
22" W.O. N 65 E 122 LINKS (80.52') (GONE)

(Witnesses Continued on Back ...)

B. Description of corner evidence found and/or method applied in restoring or reestablishing corner:

1" i.p. with 1/2" i.r. inside the pipe in a mon. box (no cover). Dist. to 1-13 = 2639.59'(R), 2639.26 (M), M-12 = 2633.09' (R), 2632.74' (M),

C. Description of monument for corner and accessories established to perpetuate locating the position of the corner:

11/01/1994 Wilkerson 21584 O.H.M. Remon
COMMON CORNER TO 4 TWPS.
SET W.C.R. WASHER AND CAP OVER CORNER
6 SET P.K. WITH W.C.R. TAG IN U.P. N60E 83.30'
7 SET P.K. WITH W.C.R. TAG IN U.P. S25E 49.90'
8 SET P.K. WITH W.C.R. TAG N28W 59.30'
13 SET P.K. WITH W.C.R. TAG IN U.P. N20E 127.60'
14 ANGLE TO R. B.S. K-13 = 90-01'40"


\$ 16.00 MISCELLANEOUS RECORDING
21 DEC 94 3:24 P.M. RECEIPT# 93A
RECORDED
FOREST E. YOUNGBLOOD, REGISTER OF DEEDS
WAYNE COUNTY, MI

We conclude that after careful study of the record documentation and field observations, that this corner is accepted as the best available evidence of the position of the original corner.

Signed by [Signature]
Drafted by Kenneth S. Wilkerson
Surveyor's Michigan License No. 21584

Date Dec 94

Orchard, Hiltz and McCliment, Inc. 34935 Schoolcraft Road Livonia, MI 48150

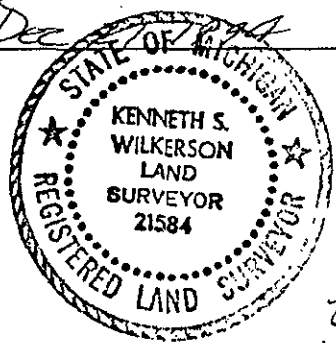

ZR
12-21-94

A. (Continued) Description of original monument and accessories and/or subsequent restorations:

01/01/1930	Wayne Co. B/T	Fd. stone	
1	12" OAK NORTHWEST 78.89' (GONE)	LI27794PA341	
2	W.R.C. SIGN NORTHEAST 43.83' (GONE)		
3	MON. SOUTHEAST 39.21' (GONE)		
4	TEL. POLE SOUTHEAST 37.11' (GONE)		
5	MON. SOUTHWEST 37.90' (GONE)		
11	DIST = 2639.59' TO L-13		
12	DIST = 2633.09' TO M-12		
14	ANGLE TO RIGHT B.S. L-13 = 89-52'01"		
11/01/1967	D.E.		Fd. stone
1	12" OAK NORTHWEST 78.89' (GONE)		
2	W.R.C. SIGH NORTHEAST 43.83' (GONE)		
3	MON. SOUTHEAST 39.21' (GONE)		
4	TEL. POLE SOUTHEAST 37.11' (GONE)		
5	MON. SOUTHWEST 37.90' (GONE)		
05/01/1970	Wayne Co. Rd. Comm.	Fd. iron in mon. box	
1	12" OAK NORTHWEST 78.33' (GONE)		
6	ED. POLE NORTHEAST 82.85'		
7	M.B.T. POLE SOUTHEAST 50.66'		
03/11/1976	Wayne Co. Rd. Comm.	Fd. iron in mon. box	
1	NAIL W/ WCR TAG ON NE /S 12" OAK NW 78.37'(GONE)		
6	NAIL W/WCRC TAG ON SW SIDE M.B.T. POLE NE 83.14'		
7	NAIL W/WCRC TAG ON SW SIDE OF M.B.T POLE SE 49.79'		
8	NAIL W/WCRC TAG ON N.E. SIDE D.E. POLE NW 59.46'		
9	"X" CUT ON S. END 36" CROSS TILE SW 38.81' (GONE)		
06/09/1979	Swanson 9748 W.C.R.C.	Fd. iron pipe in mon. box	
6	NAIL W/WCRC TAG ON S.W. SIDE M.B.T. POLE NE 83.12'		
7	NAIL W/WCRC TAG ON S.W. SIDE M.B.T POLE SE 49.79'		
8	NAIL W/WCRC TAG ON N.E. SIDE D.E. POLE NW 59.45'		
10	NAIL W/WCR TAG IN S.E./ S 27" WILLOW SE 83.66'		