

LAND CORNER RECORDATION CERTIFICATE

Filing Requirement of Act 74, Mich. P.A. 1970

L127802PA187

SEQUENCE # 2

K-11 Page 1

For corners in

Wayne

Located in: Romulus Corner Code

County <b>ROMULUS</b>					
1. Public Land Survey	T <u>3</u>	S	R <u>9</u>	E	<u>K-11</u>
	T		R		
	T		R		
	T		R		<u>Seq. 2</u>
2. Property Controlling In Section	S	T	R		
	S	T	R		
3. Miscellaneous Property in Sec.	S	T	R		
	S	T	R		
4. Lot No. _____, Recorded Plat _____					
5. Private Claims _____					

Compliance with  
ACT 345, P.A. 1990

APPROVED ON: 12-9-94 *[Signature]*  
WAYNE COUNTY REMONUMENTATION  
PEER GROUP COMMITTEE

Register of Deeds Stamp and File Number

RC 1622

I, Kenneth S. Wilkerson in a field survey on 11/30/1994  
do hereby certify that under requirements of P.A. 74, Michigan P.A. of 1970, the corner points mentioned in lines 1 and 2 above were in conformance with regulations and rules therefore as required in the current manual of survey instructions of the United States Department of the Interior, Bureau of Land Management, or by a decree of a Court of Law and/or that the corner points mentioned in lines 3, 4 and 5 above were in conformance with the rules of the Michigan Board of Land Surveyors or by a Decree of a Court of Law, established, re-established, monumented, re-monumented, recovered, found as expressed below.

NOTE: Not more than 4 corners, all in the same town and range, may be recorded on this certificate.

	A	B	C	D	E	F	G	H	I	J	K	L	M
2	8	5	4	3	2								
3													
4	7	8	9	10	11	12							
5													
6	18	17	16	15	14	13							
7													
8	19	20	21	22	23	24							
9													
10	30	29	28	27	26	25							
11													
12	31	32	33	34	35	36							
13													

A. Description of original monument and accessories and/or subsequent restorations:

01/01/1930

B of T Mon.

- 6 NE 127.72 NAIL IN NE FACE PP
- 7 SW 82.21 NAIL IN SE FACE MBT P

(Witnesses Continued on Back ...)

B. Description of corner evidence found and/or method applied in restoring or reestablishing corner:

Fd. conc. mon. in mon. box

C. Description of monument for corner and accessories established to perpetuate locating the position of the corner:

11/30/1994 Wilkerson 21584 O.H.M. Remon.

- SET W.C.R. WASHER AND CAP ON CORNER
- 10 317 AZ 65.86 WCRC TAG IN NE FACE PP
- 14 045 AZ 73.49 WCRC TAG IN SE FACE PP
- 15 136 AZ 55.84 CUT CROSS IN NE BOLT OF GAS STATION HIGH BAS
- 16 224 AZ 66.45 WCRC TAG AND PK IN SE FACE PP


\$ 16.00 MISCELLANEOUS RECORDING  
28 DEC 94 11:36 P.M. RECEIPT# 51B  
RECORDED  
FOREST E. YOUNGBLOOD, REGISTER OF DEEDS  
WAYNE COUNTY, MI

We conclude that after careful study of the record documentation and field observations, that this corner is accepted as the best available evidence of the position of the original corner.

Signed by [Signature]  
Drafted by Kenneth S. Wilkerson  
Surveyor's Michigan License No. 21584  
Orchard, Hiltz and McCliment, Inc. 34935 Schoolcraft Road Livonia, MI 48150

Date

Dec 9 1994

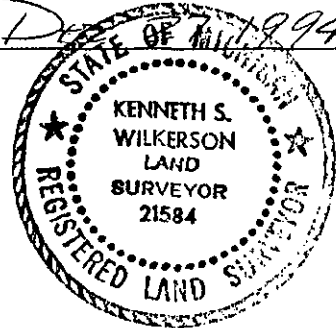

2R  
14 D  
MISC