

FEB 28 1994

LI 27033 PA 871

COMMISSION

LAND CORNER RECORDATION CERTIFICATE
Filing Requirement of Act 74, Mich. P.A. 1970

For corners in

Table with columns: WAYNE (County), Located In: CITY OF TAYLOR, Corner Code #. Rows include Public Land Survey, Property Controlling in Section, Miscellaneous Property in Sec.

Compliance with ACT 345, P.A. 1990
APPROVED ON: 11-30-93
WAYNE COUNTY REMONUMENTATION PEER GROUP COMMITTEE

Register of Deeds Stamp & File Number

RC 1290

4. Lot No. , Recorded Plat
5. Private Claims

I, E. PATRICK O'ROURKE, in a field survey on NOVEMBER 30, 19 93, do hereby certify that under requirements of P.A. 74, Michigan P.A. of 1970, the corner points mentioned in lines 1 and 2 above were in conformance with regulations and rules therefore as required in the current manual of survey instructions of the United States Department of the Interior, Bureau of Land Management or by a decree of a Court of Law and/or that the corner points mentioned in lines 3, 4 and 5 above were in conformance with the rules of the Michigan Board of Land Surveyors or by a Decree of a Court of Law; established, re-established, monumented, re-monumented, recovered, found as expressed below:

Grid table with columns A-M and rows 2-13. A dot is marked at row 9, column A.

NOTE: Not more than 4 corners, all in the same town and range, may be recorded on this certificate.

A. Description of original monument and accessories and/or subsequent restoration:

G.L.O. (1815-1816) SET POST
WITNESSES: BO 10" S. 9S (62.70) (GONE)
DO 10" N. 28E 194 (128.04') (GONE)
W.P.A. (1930's) WITNESSES: MON NW 137.93 (GONE)
(IRON) #118 IRON N 89.22 (GONE)
36" WILLOW NE 109.61 (GONE)
MON NE 96.91 (GONE)
24" ELM NE 21.55 (GONE)

CS #131 L.18022 P.50 (3-22-72)
CS NOT RECORDED (1-22-77)
CS #1910 L22961 P.409 (9-3-86)
L.C.R.C. #878 L.22913 P.714 (9-3-86)
L.C.R.C. #1003 L.25042 P.023 (3-4-91)


RECORDED
FEB 19 1994
PM 5:28

B. Description of corner evidence found and/or method applied in restoring or reestablishing corner:

DISTANCE TO A9 MEASURED AS 2576.86'; RECORDED 1930 W.P.A. DISTANCES OF 2576.60' AND 2576.40';
DISTANCE TO C9 MEASURED AS 2647.08'; RECORDED 1930 W.P.A. DISTANCES OF 2646.94' AND 2646.60'

L.18022 P.50 (C.S.) - FOUND MON. IN BOX (1972)
DISTANCE TO C9 = 2647.00' RECORDED: (MEAS. 2647.08')
(NO WITNESSES SHOWN ON C.S.)

(CONTINUED ON OTHER SIDE)

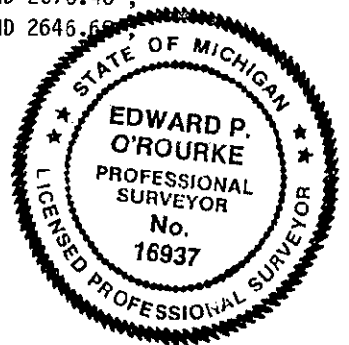

C. Description of monument for corner and accessories established to perpetuate locating the position of the corner:

B-9 SECTION CORNER 19 & 30, T3S, R10E
FOUND 1/2" IRON ROD IN A HANDHOLE ROAD BOX AT NORTHLINE AND LANGE ROADS AND IT IS ACCEPTED AS A CAREFUL AND FAITHFUL PERPETUATION OF THE POSITION OF THE ORIGINAL CORNER.

WITNESSES: S 53°09'E 62.32' FOUND C/L TOP BOLT ON FIRE HYDRANT (SUPRA)
N 66°37'E 94.76' (SET) C/L ANCHOR BOLT IN BASE OF STEEL LIGHT POLE
S 44°27'W 54.32' (SET) C/L ANCHOR BOLT IN BASE OF STEEL LIGHT POLE
N 46°54'W 56.10' FOUND CHISELED "X" ON SE RIM OF STORM MH (SUPRA)

PLACED A REMONUMENTATION BRASS DISC AND CAP #16937 ON ABOVE FOUND 1/2" IRON ROD B-9.

Signed by [Signature]
Surveyor's Michigan License No. 16937

Date NOVEMBER 30, 1993

12/13/93 35696 DEED 14.00  
12/13/93 35696 REMO FEE 2.00

FILE DO NOT MAIL

SECTION B (CONTINUED)

UNRECORDED C.S. - FOUND CONC. MONUMENT IN MONUMENT BOX (1977)

N. 45°04'E	43.65'	P.K. NAIL S.E. SIDE MBT POLE (GONE)
S. 32°53'E	60.41'	P.K. NAIL S.W. SIDE MBT POLE (GONE)
S. 29°57'W	62.66'	P.K. NAIL S.E. SIDE MBT POLE (MEAS. 62.59')
N. 78°27'W	84.67'	C/L BASE OF MAIL BOX (GONE)

L.22913 P.714 - FOUND MONUMENT IN MONUMENT BOX (1986)

N. 44°59'E	43.58'	P.K. NAIL N.W. SIDE LIGHT POLE (GONE)
S. 55°00'E	62.45'	ARROW ION TOP OF FIRE HYDRANT (MEAS. 62.32')
S. 33°59'E	59.47'	P.K. NAIL W. SIDE UTILITY POLE (MEAS. 59.38')
S. 29°37'W	62.73'	P.K. NAIL S.E. SIDE UTILITY POLE (MEAS. 62.59')

L.22961 P.409-411 (C.S.) - FOUND MONUMENT IN BOX (1986)

DISTANCE TO B10 RECORDED AS 2673.58'; MEASURED AS 2673.56';  
SAME WITNESS DATA AS L.22913 P.714 ABOVE.

L.25042 P.23 - RESET A 3/8" REROD IN A ROAD BOX AFTER COMPLETION OF PAVING CONSTRUCTION (USING PREVIOUS WITNESS) (1991)

S. 54°52'E	62.43'	C/L OF TOP BOLT OF FIRE HYDRANT (MEAS. 62.32')
S. 33°59'E	59.33'	P.K. NAIL ON WEST SIDE OF A UTILITY POLE (MEAS. 59.38')
S. 30°03'W	62.62'	P.K. NAIL ON SOUTHEAST SIDE OF A UTILITY POLE (MEAS. 62.59')
N. 48°39'W	56.08'	CHISELED "X" ON THE SOUTHEAST EDGE OF A STORM M.H. RIM (MEAS. 56.10')