

COMMISSION

LAND CORNER RECORDATION CERTIFICATE
Filing Requirement of Act 74, Mich. P.A. 1970

For corners in

Table with columns: WAYNE (County), Located In: CITY OF TAYLOR, Corner Code #. Rows include Public Land Survey, Property Controlling in Section, and Miscellaneous Property in Sec.

Compliance with ACT 345, P.A. 1990
APPROVED ON: 11-30-93
WAYNE COUNTY REMONUMENTATION PEER GROUP COMMITTEE
Register of Deeds Stamp & File Number

- 4. Lot No.
5. Private Claims

I, E. PATRICK O'ROURKE, in a field survey on NOVEMBER 30, 1993, do hereby certify that under requirements of P.A. 74, Michigan P.A. of 1970, the corner points mentioned in lines 1 and 2 above were in conformance with regulations and rules therefore as required in the current manual of survey instructions of the United States Department of the Interior, Bureau of Land Management or by a decree of a Court of Law and/or that the corner points mentioned in lines 3, 4 and 5 above were in conformance with the rules of the Michigan Board of Land Surveyors or by a Decree of a Court of Law, established, re-established, monumented, re-monumented, recovered, found as expressed below:

NOTE: Not more than 4 corners, all in the same town and range, may be recorded on this certificate.

A. Description of original monument and accessories and/or subsequent restoration:

G.L.O. (1815-1816) DESCRIPTION OF CORNER NOT STATED IN NOTES.
WITNESSES: W.O. 16 West 33 (21.78') (GONE)
B.O. 12 N12W 57 (37.62') (GONE)
W.P.A. (1930's) - FOUND CROSS (#142)
WITNESSES: N'LY 0.45' CROSS (GONE)
SE'LY 50.50' 5" ELM (GONE)
SW'LY 72.70' 3" ELM (GONE)
NW'LY 44.75' NAIL NE SIDE ED POLE (GONE)

B. Description of corner evidence found and/or method applied in restoring or reestablishing corner:

DISTANCE TO B10 MEASURED AS 2548.34'; RECORD W.P.A. (1930) DISTANCE - NONE SHOWN:
DISTANCE TO C11 MEASURED AS 2620.39'; RECORD W.P.A. (1930) DISTANCE OF 2619.34';
DISTANCE TO A11 MEASURED AS 2631.84'; RECORD W.P.A. (1930) DISTANCE OF 2631.57';

L.18661 P.528 & 529 (C.S.) - NO DESCRIPTION OF CORNER STATED ON (C.S.) (1973)
NO WITNESSES SHOWN ON ABOVE (C.S.)


L.19356 P.69 - FOUND CONCRETE MONUMENT IN BOX (1976)
NW 66.51' SPIKE WITH BRASS TAG IN NE SIDE OF DE POLE (MEAS. N 32°W, 66.32')
NE 91.00' "V" CUT IN E SIDE OF METAL SIGN BASE OF PENRICKTON CENTER SIGN (MEAS. N 37°E, 90.87')
SE 79.46' NW CORNER OF THIRD BRICK UP FROM FOUNDATION BLDG. #26541 (MEAS. S 42°E, 79.49')
SW 86.37' SPIKE WITH BRASS TAG ION NW SIDE OF DE POLE (MEAS. S 24°W, 86.44')
(CONTINUED ON OTHER SIDE)

C. Description of monument for corner and accessories established to perpetuate locating the position of the corner:

B-11 SECTION CORNER 30 & 31, T3S, R10E.
FOUND 1/2" IRON PIPE IN HANDHOLE ROAD BOX AT EUREKA AND LANGE ROADS AND IT IS ACCEPTED AS A CAREFUL AND FAITHFUL PERPETUATION OF THE POSITION OF THE ORIGINAL CORNER.
WITNESSES: N 21°57'E 103.05' FOUND CENTER OF TOP BOLT OF FIRE HYDRANT (SUPRA)
N 48°06'E 62.74' FOUND CHISELED "X" IN SW ANCHOR BOLT IN BASE OF STEEL LIGHT POLE (SUPRA)
S 61°15'W 108.46' FOUND CHISELED "X" IN NE ANCHOR BOLT IN BASE OF STEEL LIGHT POLE (SUPRA)
N 32°29'W 66.32' FOUND NAIL IN BRASS TAG ON NE SIDE UTILITY POLE (SUPRA)

PLACED A REMONUMENTATION BRASS DISC AND CAP #16937 ON ABOVE FOUND 1/2" IRON PIPE B11.

Grid table with columns A-M and rows 1-13. A dot is marked at row 11, column B.

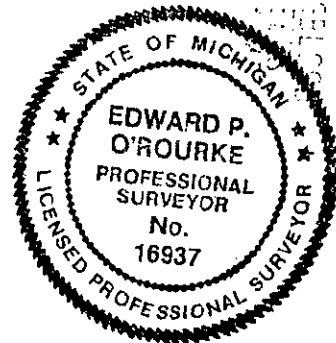

Signed by E. PATRICK O'ROURKE
Surveyor's Michigan License No. 16937

Date NOVEMBER 30, 1993

12/13/93 35696 REMO FEE 2.00  
12/13/93 35696 DEED 14.00

FILE DO NOT MAIL

SECTION B (CONTINUED)

UNRECORDED (C.S.) - FOUND CONC. MONUMENT IN MONUMENT BOX (1977)  
SAME WITNESSES AS L.19356 P.69 ABOVE

L.22961 P.409-412 (C.S.) - FOUND MONUMENT IN BOX (1986)

DISTANCE TO B10 RECORDED AS 2548.34'; MEASURED AS 2548.34';

DISTANCE TO A11 RECORDED AS 2631.66'; MEASURED AS 2631.84';

|            |           |         |  |
|------------|-----------|---------|--|
| WITNESSES: | N 22°01'E | 103.06' | TIP OF ARROW ON F. HYD. (MEAS. 103.05')            |
|            | N 48°05'E | 62.72'  | CROSS ON SW BOLT IN BASE LIGHT POLE (MEAS. 62.74') |
|            | S 61°15'W | 108.46' | CROSS ON NE BOLT IN BASE LIGHT POLE (MEAS. 108.46) |
|            | N 32°28'W | 66.35'  | REF. NAIL NE SIDE UTILITY POLE (MEAS. 66.32')      |

L.22913 P.715 - FOUND MONUMENT IN MONUMENT BOX (1986)

SAME WITNESSES AS L.22961 P.409-412 ABOVE.