

FEB 28 1994

COMMISSION

LAND CORNER RECORDATION CERTIFICATE

Filing Requirement of Act 74, Mich. P.A. 1970

For corners in

WAYNE (County)

Located In: CITY OF TAYLOR

Corner Code #/

- 1. Public Land Survey T 3S R 10E C-2
2. Property Controlling in Section S T R
3. Miscellaneous Property in Sec. S T R

Compliance with ACT 345, P.A. 1990
APPROVED ON: 11-30-93 J.P.D.
WAYNE COUNTY REMONUMENTATION PEER GROUP COMMITTEE

Register of Deeds Stamp & File Number

RC 1307

- 4. Lot No. , Recorded Plat
5. Private Claims

Grid table with columns A-M and rows 2-13. A dot is marked at row 2, column C.

I, E. PATRICK O'ROURKE, in a field survey on NOVEMBER 30, 1993, do hereby certify that under requirements of P.A. 74, Michigan P.A. of 1970, the corner points mentioned in lines 1 and 2 above were in conformance with regulations and rules therefore as required in the current manual of survey instructions of the United States Department of the Interior, Bureau of Land Management or by a decree of a Court of Law and/or that the corner points mentioned in lines 3, 4 and 5 above were in conformance with the rules of the Michigan Board of Land Surveyors or by a Decree of a Court of Law; established, re-established, monumented, re-monumented, recovered, found as expressed below:

NOTE: Not more than 4 corners, all in the same town and range, may be recorded on this certificate.

A. Description of original monument and accessories and/or subsequent restoration:

G.L.O. (1815-1816) DESCRIPTION OF CORNER NOT STATED IN NOTES.

WITNESSES: B0 9 S 12 E 8 (5.28') (GONE)
DO 10 S 22 W 42 (27.72') (GONE)

W.P.A. (1930's) - FOUND IRON (#16)

WITNESSES: NE'LY 78.20' Mon. (GONE)
NE'LY 62.14' NAIL SE SIDE 15" OAK (GONE)
SE'LY 40.98' SIGN POST (GONE)
NW'LY 71.28' MON. (GONE)

B. Description of corner evidence found and/or method applied in restoring or reestablishing corner:

DISTANCE TO C3 MEASURED AS 2683.14'; RECORD W.P.A. (1930) 2683.20' AND 2682.85'

L.18356 P.866 & 869 - NO DESCRIPTION OF SECTION CORNER C2 (1973)
NO WITNESSES SHOWN ON SAID (C.S.)

L.18385 P.560 - NO DESCRIPTION OF SECTION CORNER C2 (1973)
NO WITNESSES SHOWN ON SAID (C.S.)

UNRECORDED (C.S.)- FOUND 1/2" IRON PIPE (1985)

N. 46°E 68.28' P.K. NAIL S. SIDE DEAD MAN POLE (MEAS. 68.24')
N. 71°E 55.76' P.K. NAIL S.W. SIDE 6" TREE (GONE)
S. 66°W 68.95' P.K. NAIL N. SIDE 8" TREE (GONE)
N. 49°W 62.45' NAIL IN CAP NW SIDE D.E. LIGHT POLE (MEAS.62.45')

L.23751 P.511 FOUND CONC. MON. IN MON. BOX (1988)
SAME WITNESSES AS UNRECORDED (C.S.) ABOVE.

C. Description of monument for corner and accessories established to perpetuate locating the position of the corner:


C-2 SECTION CORNER 5 & 6, T3S, R10E.

FOUND A CONC. MONUMENT IN A HANDHOLE ROAD BOX IN BEECH DALY ROAD AND IT IS ACCEPTED AS A CAREFUL AND FAITHFUL PERPETUATION OF THE POSITION OF THE ORIGINAL CORNER.

WITNESSES: N 46°32'E 68.24' FOUND NAIL IN BRASS TAG ON N SIDE OF DEADMAN POLE (SUPRA)
S 77°45'E 71.40' SET NAIL IN SHINER ON S SIDE TWIN 10" TREE (NAIL IS 4' ABOVE GROUND)
S 46°40'W 37.76' SET NAIL IN SHINER ATOP N END POST OF GUARD RAIL
N 47°24'W 62.45' FOUND NAIL IN BRASS CAP ON NW SIDE OF DE LIGHT POLE (SUPRA)

PLACED A REMONUMENTATION BRASS DISC AND CAP #16937 ON ABOVE FOUND MONUMENT C-2.

93 DEC 13 PM 5:29

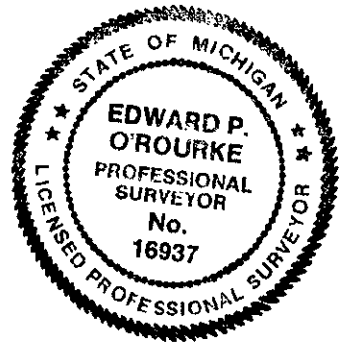

Signed by [Signature]
E. PATRICK O'ROURKE
Surveyor's Michigan License No. 16937

Date NOVEMBER 30, 1993

2R
11K11