

FILE DO NOT MAIL

LAND CORNER RECORDATION CERTIFICATE

Filing Requirement of Act 74, Mich. P.A. 1970 Page-572.0
97327853LS 12/15/1997 08:47AM
Liber-29739 Page-572.0
97327853LS 12/15/1997 08:47AM

For corners in

WAYNE (County)

Located in: Corner Code #
CITY OF TAYLOR (TOWNSHIP #14)

- 1. Public Land Survey T3S R 10E C-9
2. Property Controlling in Section S T R SURVEY & REMONUMENTATION
3. Miscellaneous Property in Sec. S T R
4. Lot No. Recorded Plat
5. Private Claims SECTION

Compliance with ACT 345, P.A. 1990

APPROVED ON: 11-13-97
WAYNE COUNTY REMONUMENTATION PEER GROUP COMMITTEE

Register of Deeds Stamp & File Number

I, WALTER J. ZBIKOWSKI, in a field survey on NOVEMBER 25, 1997, do hereby certify that under requirements of P.A. 74, Michigan P.A. of 1970, the corner points mentioned in lines 1 and 2 above were in conformance with regulations and rules therefore as required in the current manual of survey instructions of the United States Department of the Interior, Bureau of Land Management or by a decree of a Court of Law and/or that the corner points mentioned in lines 3, 4 and 5 above were in conformance with the rules of the Michigan Board of Land Surveyors or by a Decree of a Court of Law; established, re-established, monumented, re-monumented, recovered, found as expressed below.

NOTE: Not more than 4 corners, all in the same town and range, may be recorded on this certificate.

A. Description of original monument and accessories and/or subsequent restoration.

ORIGINAL GOVERNMENT SURVEY BY JOSEPH FLETCHER, D.S. (1815-1817) G.L.O. (1817) NORTH BETWEEN SEC 29-30, T.3S., R.10E., 80.00 CHAINS COR SEC 19-20-29-30 (DESCRIPTION OF CORNER NOT STATED IN NOTES) WITNESSES: BO 10" N 58 E 13 (LINKS) (8.58') (GONE) DO 12" S 18 W 34 (LINKS) (22.44') (GONE)

RESURVEY AT THE DIRECTION OF ALBERT CHAMPNEY, DIRECTOR OF WAYNE COUNTY BUREAU OF TAXATION

W.P.A. (1930's) IRON, NW-29 (#115) WITNESSES: NE 61.65' 16" OAK (GONE) ENE 82.61' 24" OAK STUMP (GONE) SE 73.89' TEL POLE (GONE) SW 52.96' MON. (GONE) NW 48.50' MON. (GONE)

\$4.00 REMONUMENTATION RECORDED FOREST E. YOUNGBLOOD, REGISTER OF DEEDS WAYNE COUNTY, MI Receipt #41828

B. Description of corner evidence found and/or method applied in restoring or reestablishing corner. FOUND A 3/8" REBAR IN A ROAD BOX WITH LID (BOTH GOOD) IN THE CENTER LANES OF NORTHLINE ROAD (A FIVE LANE CONCRETE ROAD) AND BEECH DALY ROAD (A FIVE LANE ASPHALT SURFACED ROAD). DISTANCE TO C-8 MEASURED AS 2640.21'; MEASURED DISTANCE REVISED TO 2640.00' AS RESULT OF APPROVED POSITION OF REMONUMENTATION PEER REVIEW; G.L.O. (1817) RECORD DISTANCE OF 40 CHAINS (2640.00'); W.P.A. (1930's) RECORD DISTANCE OF 2640.00'; DISTANCE TO D-9 MEASURED AS 2586.00'; G.L.O. (1817) RECORD DISTANCE OF 39.75 CHAINS (2623.50'); W.P.A. (1930's) RECORD DISTANCES OF 2585.32' AND 2585.53'; DISTANCE TO C-10 MEASURED AS 2635.53'; MEASURED DISTANCE REVISED TO 2635.74' AS RESULT OF APPROVED POSITION OF REMONUMENTATION PEER REVIEW; G.L.O. (1817) RECORD DISTANCE OF 40 CHAINS (2640.00'); W.P.A. (1930's) RECORD DISTANCES OF 2635.80' AND 2635.92';

(CONTINUED ON BACK)

\$10.00 DEED

C. Description of monument for corner and accessories established to perpetuate locating the position of the corner. C-9, SECTION CORNER 19-20-29-30, T.3S., R.10E

SET A 1/2" X 48" STEEL REBAR IN A ROAD BOX WITH LID (BOTH GOOD) IN THE CENTER LANES OF NORTHLINE ROAD (A FIVE LANE CONCRETE ROAD) AND BEECH DALY ROAD (A FIVE LANE ASPHALT SURFACED ROAD) AND IT IS ACCEPTED AS A CAREFUL AND FAITHFUL PERPETUATION OF THE POSITION OF THE ORIGINAL CORNER.

WITNESSES: N 42°52' E 84.50' FOUND A CHISELED "X" ON THE SOUTHWEST BOLT IN THE BASE OF A STEEL LIGHT S 27°28' E 79.89' FOUND A CHISELED "X" ON THE SOUTHWEST BOLT IN THE BASE OF A STEEL LIGHT S 44°52' W 73.00' FOUND A CHISELED "X" ON THE NORTHWEST BOLT IN THE BASE OF A STEEL LIGHT N 46°03' W 73.61' FOUND A CHISELED "X" ON THE S/S CONCRETE BASE OF A TRAFFIC SIGNAL POLE


PLACED A REMONUMENTATION DISC AND PVC CAP #21586 ON ABOVE 1/2" X 48" STEEL REBAR C-9.

Signed by Walter J. Zbikowski WALTER J. ZBIKOWSKI Surveyor's Michigan License No. 21586

Date DEC. 8, 1997

R-LCR-10-4R-2PG-U

Grid table with columns A-M and rows 2-13. A black dot is located at row 9, column C.

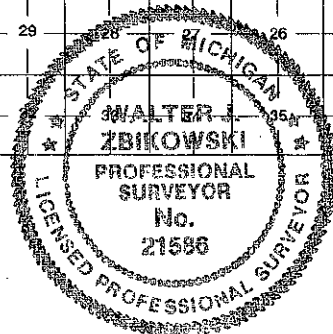

B. CONTINUED

DISTANCE TO B-9 MEASURED AS 2646.95'; G.L.O. (1817) RECORD DISTANCE OF 40 CHAINS; (2640.00'); W.P.A. (1930's) RECORD DISTANCES OF 2646.68' AND 2646.94'; C.S. (1972) (L.18022 P.50 C.S. 131) RECORD DISTANCE OF 2647.00';

L.18022, P.11, FOUND IRON BAR IN MONUMENT BOX (1972) LCRC #47

WITNESSES: N 56° E 64.65' TO PK NAIL IN POLE (GONE)
S 28° W 72.25' TO WCRC NAIL IN POLE (GONE)
N 37° W 52.70' TO PK NAIL IN DE POLE (GONE)

L.25042 P.23, RESET A 3/8" REBAR IN A ROAD BOX AFTER COMPLETION OF A PAVING CONSTRUCTION BY USING PRECONSTRUCTION REFERENCE LINES/POINTS (1991) LCRC #1003

WITNESSES: N 50°14' E 76.90' TO A PK NAIL ON THE NORTHWEST SIDE OF A UTILITY POLE (GONE)
S 27°28' E 79.73' TO A CHISELED "X" ON THE SOUTHWEST BOLT IN THE BASE OF A STEEL LIGHT POLE (MEASURED 79.74')
S 44°52' W 72.96' TO A CHISELED "X" ON THE NORTHWEST BOLT IN THE BASE OF A STEEL LIGHT POLE (MEASURED 72.85')
N 40°03' W 62.72' TO A PK NAIL ON THE EAST SIDE OF A UTILITY POLE (GONE)

SURVEY &
REMONUMENTATION

JEC 01 2000

SECTION

FILE DO NOT MAIL