

FEB 28 1994

COMMISSION

LAND CORNER RECORDATION CERTIFICATE

Filing Requirement of Act 74, Mich. P.A. 1970

For corners in

WAYNE (County)	Located In: CITY OF TAYLOR	Corner Code #
1. Public Land Survey	T 3S R 10E	C-11
	T _____ R _____	_____
	T _____ R _____	_____
	T _____ R _____	_____
2. Property Controlling in Section	S _____ T _____ R _____	_____
	S _____ T _____ R _____	_____
3. Miscellaneous Property in Sec.	S _____ T _____ R _____	_____
	S _____ T _____ R _____	_____

Compliance with
ACT 345, P.A. 1990

APPROVED ON: 11-30-93 *DRJ*

WAYNE COUNTY REMONUMENTATION
PEER GROUP COMMITTEE

Register of Deeds Stamp & File Number

RC 1294

- 4. Lot No. _____, Recorded Plat _____
- 5. Private Claims _____


I, E. PATRICK O'ROURKE, in a field survey on NOVEMBER 30, 19 93, do hereby certify that under requirements of P.A. 74, Michigan P.A. of 1970, the corner points mentioned in lines 1 and 2 above were in conformance with regulations and rules therefore as required in the current manual of survey instructions of the United States Department of the Interior, Bureau of Land Management or by a decree of a Court of Law and/or that the corner points mentioned in lines 3, 4 and 5 above were in conformance with the rules of the Michigan Board of Land Surveyors or by a Decree of a Court of Law; established, re-established, monumented, re-monumented, recovered, found as expressed below:

NOTE: Not more than 4 corners, all in the same town and range, may be recorded on this certificate.

	A	B	C	D	E	F	G	H	I	J	K	L	M
2	6		5		4		3		2		1		
3													
4	7		8		9		10		11		12		
5													
6	18		17		16		15		14		13		
7													
8	19		20		21		22		23		24		
9													
10	30		29		28		27		26		25		
11													
12	31		32		33		34		35		36		
13													

A. Description of original monument and accessories and/or subsequent restoration:

- G.L.O. (1815-1816) DESCRIPTION OF CORNER NOT STATED IN NOTES.
- WITNESSES: POPLA 9 N 35 E 3.37 (2.22') (GONE)
- DO 9 N 52 W 5.37 (3.54') (GONE)
- W.P.A. (1930's) - FOUND IRON (#141)
- WITNESSES: NE'LY 144.73' NAIL S. SIDE 6" ELM (GONE)
- SE'LY 75.10' IRON (GONE)
- SW'LY 135.17' NAIL NW SIDE 4" ELM (GONE)
- NW'LY 46.05' CROSS ON BASE OF SIGN POST (GONE)

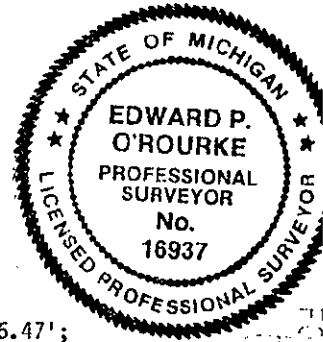

B. Description of corner evidence found and/or method applied in restoring or reestablishing corner:

DISTANCE TO C10 MEASURED AS 2637.08'; RECORD W.P.A. (1930) DISTANCES OF 2636.48' AND 2636.47';
 DISTANCE TO D11 TRAVERSED AS 2639.68'; RECORD W.P.A. (1930) DISTANCES OF 2639.48' AND 2639.76';
 DISTANCE TO C12 MEASURED AS 2624.24'; RECORD W.P.A. (1930) DISTANCES OF 2623.57' AND 2623.90';
 DISTANCE TO B11 MEASURED AS 2620.41'; RECORD W.P.A. (1930) DISTANCE OF 2619.34'.

L.19026 P.904 - FOUND CONC. MONUMENT THAT REPLACES EXISTING CONC. MONUMENT (1974) (MEAS. 79.09')
 N.W. 79.06' CENTER OF BRASS PLUG OF PRECISE BM @ N.W. CORNER OF EUREKA AND BEECH DALY
 N.E. 77.77' "X" CUT IN KEY SIDEWALK FLAG @ N.E. CORNER OF EUREKA AND BEECH DALY (MEAS. 77.67')
 S.E. 81.57' SPIKE WITH BRASS TAG IN S.W. SIDE OF MICH. BELL POLE (GONE)
 S.W. 93.39' SPIKE WITH BRASS TAG IN S.E. SIDE OF MICH. BELL POLE (GONE)

(CONTINUED ON OTHER SIDE)

C. Description of monument for corner and accessories established to perpetuate locating the position of the corner:

C-11 SECTION CORNER 29, 30, 31, & 32, T3S, R10E
 FOUND 1/2" IRON IN CONCRETE IN A HANDHOLE ROAD BOX AT EUREKA AND BEECH DALY ROADS AND IT IS ACCEPTED AS A CAREFUL AND FAITHFUL PERPETUATION OF THE POSITION OF THE ORIGINAL CORNER.
 WITNESSES: N 55°57'E 79.66' FOUND "X" CUT IN NW ANCHOR BOLT IN BASE OF STEEL LIGHT POLE (SUPRA)
 S 58°36'E 83.86' FOUND "X" CUT IN SW ANCHOR BOLT IN BASE OF STEEL LIGHT POLE (SUPRA)
 S 57°51'W 82.30' FOUND "X" CUT IN NW ANCHOR BOLT IN BASE OF STEEL LIGHT POLE (SUPRA)
 N 57°59'W 80.75' FOUND "X" CUT IN SW ANCHOR BOLT IN BASE OF STEEL LIGHT POLE (SUPRA)

PLACED A REMONUMENTATION BRASS TAG AND CAP #16937 ON ABOVE FOUND 1/2" IRON C11.

Signed by *E. Patrick O'Rourke*
 Surveyor's Michigan License No. 16937

Date NOVEMBER 30, 1993

12/13/93 35696 REMO FEE 2.00
 12/13/93 35696 DEED 14.00

FILE DO NOT MAIL

SECTION B (CONTINUED)

UNRECORDED (C.S.) - FOUND CONC. MONUMENT IN MONUMENT BOX (1977)

- N.E. 77.77' "X" CUT IN KEY SIDEWALK FLAG (MEAS. 77.67')
- S.E. 71.16' P.K. NAIL S.W. SIDE GUY POLE (MEAS. 73.20')
- S.W. 81.68' C.L. NE BOLT OF CONC. SIGN BASE (MEAS. 81.69')
- N.W. 79.06' CENTER OF BRASS PLUG OF PRECISE B.M. (MEAS. 79.09')

L.25437 P.670 - FOUND MONUMENT IN ROAD BOX (1991)

- N 55°57' E 79.69' "X" CUT IN NW BOLT IN BASE OF STEEL LIGHT POLE (MEAS. 79.66')
- S 58°40' E 83.88' "X" CUT IN SW BOLT IN BASE OF STEEL LIGHT POLE (MEAS. 83.86')
- S 57°57' W 82.25' "X" CUT IN NW BOLT IN BASE OF STEEL LIGHT POLE (MEAS. 82.30')
- N 57°58' W 80.79' "X" CUT IN SW BOLT IN BASE OF STEEL LIGHT POLE (MEAS. 80.75')