

LAND CORNER RECORDATION CERTIFICATE
Filing Requirement of Act 74, Mich. P.A. 1970

For corners in


<u>WAYNE</u> (County)	Located in: CITY OF TAYLOR TOWNSHIP #14	Corner Code # E-12
1. Public Land Survey	T <u>3S</u> R <u>10E</u>	<u>E-12</u>
	T_____ R_____	_____
	T_____ R_____	_____
	T_____ R_____	_____
2. Property Controlling in Section	S_____ T_____ R_____	_____
	S_____ T_____ R_____	_____
3. Miscellaneous Property in Sec.	S_____ T_____ R_____	_____
	S_____ T_____ R_____	_____
4. Lot No. _____, Recorded Plat _____		
5. Private Claims _____		

LIBER 29337 PAGE 564

Compliance with
ACT 345, P.A. 1990
APPROVED ON: 11-13-96
WAYNE COUNTY REMONUMENTATION
PEER GROUP COMMITTEE

Register of Deeds Stamp & File Number

A	B	C	D	E	F	G	H	I	J	K	L	M
2	6		5		4		3		2		1	
3												
4	7		8		9		10		11		12	
5												
6	18		17		16		15		14		13	
7												
8	19		20		21		22		23		24	
9												
10	30		29		28		27		26		25	
11												
12	31		32		33		34		35		36	
13												

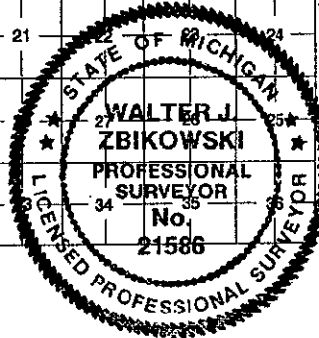

I, WALTER J. ZBIKOWSKI, in a field survey on SEPTEMBER 30, 1996, do hereby certify that under requirements of P.A. 74, Michigan P.A. of 1970, the corner points mentioned in lines 1 and 2 above were in conformance with regulations and rules therefore as required in the current manual of survey instructions of the United States Department of the Interior, Bureau of Land Management or by a decree of a Court of Law and/or that the corner points mentioned in lines 3, 4 and 5 above were in conformance with the rules of the Michigan Board of Land Surveyors or by a Decree of a Court of Law; established, re-established, monumented, re-monumented, recovered, found as expressed below.

NOTE: Not more than 4 corners, all in the same town and range, may be recorded on this certificate.

A. Description of original monument and accessories and/or subsequent restoration.
ORIGINAL GOVERNMENT SURVEY BY JOSEPH FLETCHER, D.S. (1815-1817)
 G.L.O. (1817) NORTH BETWEEN SEC 32-33, T.3S., R.10E, 40.00 (CHAINS) 1/4 SEC. COR (DESCRIPTION OF CORNER NOT STATED IN NOTES)

WITNESSES: B.O. 12" N 58 E 32 (LINKS) (21.12') (GONE)
 DO 10" S 80 E 82 (LINKS) (54.12') (GONE)

RESURVEY AT THE DIRECTION OF ALBERT E. CHAMPNEY, DIRECTOR OF WAYNE COUNTY BUREAU OF TAXATION
 W.P.A. (1930's) IRON IN PAVEMENT, W-33 (#148) \$ 7.00 DEED

WITNESSES: E 33.00' MON. (NOW A 1/2" IRON PIPE - MEASURED 32.72')
 SE 50.40' 4" TWIN CHERRY (GONE)
 SW 105.13' EDISON POLE (RELOCATED - MEASURED 109.16')
 NW 60.92' EDISON POLE (GONE)

12 DEC 96 2:12 P.M. RECEIPT
 RECORDED
 FOREST E. YOUNGBLOOD, REGISTER OF
 WAYNE COUNTY, MI

B. Description of corner evidence found and/or method applied in restoring or reestablishing corner.
 FOUND A 1-1/4" FLARED IRON PIPE IN A ROAD BOX (GOOD WITH NO LID) IN THE CENTER OF THE "HIGH SPEED" LANE OF NORTHBOUND TELEGRAPH ROAD (A TWO LANE CONCRETE ROAD) ONE HALF MILE NORTH OF PENNSYLVANIA ROAD (A TWO LANE CONCRETE ROAD)
 DISTANCE TO E-11 TRAVERSED AS 2573.33'; G.L.O. (1817) RECORD DISTANCE OF 40.00 CHAINS (2640.00'); W.P.A. (1930's) RECORD DISTANCES OF 2573.24' AND 2573.02'; "SUPERVISOR'S TAYLOR PLAT NO. 9"; L.66 P.26 (1938) RECORD DISTANCE OF 2573.60'; DISTANCE TO E-13 MEASURED AS 2568.56'; G.L.O. (1817) RECORD DISTANCE OF 40.00 CHAINS (2640.00'); W.P.A. (1930's) RECORD DISTANCES OF 2568.97' AND 2568.29';

L.23670 P.525, FOUND 1" IRON BAR IN MONUMENT BOX (1988) LCRC #904
 WITNESSES: N.87°E. 31.28' NAIL IN CAP, S SIDE OF DETROIT EDISON POLE (MEASURED 31.31')
 S.34°E. 50.54' PK NAIL ON SW SIDE OF 20" STUMP (GONE)
 S.08°W. 36.58' "X" CUT ON TOP OF STEEL C.B. CURB (MEASURED 36.62')
 S.55°W. 64.84' "X" CUT ON TOP OF STEEL C.B. CURB (MEASURED 64.80')

\$ 4.00 REMONUMENTATION

C. Description of monument for corner and accessories established to perpetuate locating the position of the corner.
 E-12, SECTION CORNER 32, 33 T.3S., R.10E.
 PLACED A BRASS REMONUMENTATION DISC AND PVC CAP #21586 ON 1-1/4" IRON PIPE IN A ROAD BOX IN THE CENTER OF THE "HIGH SPEED" LANE OF NORTHBOUND TELEGRAPH ROAD (A TWO LANE CONCRETE ROAD) ONE HALF MILE NORTH OF PENNSYLVANIA ROAD (A TWO LANE CONCRETE ROAD) AND IT IS A CAREFUL AND FAITHFUL PERPETUATION OF THE POSITION OF THE ORIGINAL CORNER.

WITNESSES: N.27°16'E. 96.00' SET NAIL IN WCR BRASS WITNESS DISC ON SE SIDE OF UTILITY POLE
 N.87°46'E. 31.31' FOUND PK NAIL IN MSHD BRASS DISC ON SOUTH SIDE UTILITY POLE (SUPRA)
 S.35°00'E. 53.49' CENTER OF CORNER POST OF 4' HIGH CYCLONE FENCE TO EAST AND SOUTH
 S.57°16'W. 64.80' FOUND CHISELED "X" ATOP STEEL CURB OF CATCH BASIN (SUPRA)

Signed by Walter J. Zbikowski
 Surveyor's Michigan License No. 21586

Date Dec. 11, 1996

412
70
M