

FEB 28 2000

FILE DO NOT MAIL

LAND CORNER RECORDATION CERTIFICATE
Filing Requirement of Act 74, Mich. P.A. 1970

SECTION

For corners in

Wayne (County) Located In: City of Taylor Township #14 Corner Code # G-9
1. Public Land Survey T-3-S R-10-E
2. Property Controlling in Section S T R
3. Miscellaneous Property in Sec. S T R

Liber-30803 Page-3
99585586 12/20/1999
F.E. Youngblood, Wayne Co. Register of Deeds
RDANDSYL

Compliance with ACT 345, P.A. 1990

APPROVED ON: 12-7-99
WAYNE COUNTY REMONUMENTATION PEER GROUP COMMITTEE

Register of Deeds Stamp & File Number

4. Lot No. , Recorded Plat

5. Private Claims

I, John N. Redash, in a field survey on July 23, 1999 do hereby state that under requirements of P.A. 74, Michigan P.A. of 1970, the corner points mentioned in lines 1 and 2 above were in conformance with regulations and rules therefore as required in the current manual of survey instructions of the United States Department of the Interior, Bureau of Land Management or by a decree of a Court of Law and/or that the corner points mentioned in lines 3, 4 and 5 above were in conformance with the rules of the Michigan Board of Land Surveyors or by a Decree of a Court of Law; established, re-established, monumented, recovered, found as expressed below:

NOTE: Not more than 2 corners, all in the same town and range, may be recorded on this certificate.

Grid table with columns A-M and rows 1-13. A dot is marked at the intersection of column G and row 9.

A. Description of original monument and accessories and/or subsequent restoration:

G.L.O. (1817) Corner section 21, 22, 27 and 28 (description of corner not stated)

Witnessed as: Poplar 10" N. 79° E. 1.2 links (gone)
D.O. 6" N. 57° E. 1.5 links (gone)

W.P.A. (1930's), Iron, NW-27 (#111)

Witnesses:

S.E. 21.00' Edison pole (gone) WNW 86.23' Edison pole (gone)
SSW 29.56' 3" Elm (gone) NW 45.70' 12" Maple (gone)
SW 128.43' Base 24" Maple (gone) NNW 24.70' 10" Maple (gone)


\$12.00 DEED

Receipt #19121

RECORDED

FOREST E. YOUNGBLOOD, REGISTER OF DEEDS

WAYNE COUNTY #71201

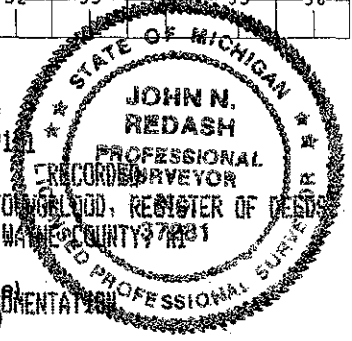

B. Description of corner evidence found and/or method applied in restoring or reestablishing corner:

A concrete monument in a monument box in 5 lane concrete pavement (Northline Road) occupies this corner. The position of this monument has been questioned. An alternate point through existing monumentation within "Supervisors Taylor Plat No. 2" as recorded in Liber 66, Page 6, Wayne County Records has been determined. No witness accessories are available from L.C.R.C. Liber 25042, Page 21. Field measurements were observed between the following corners:

Table with 4 columns: F-9 to G-9, G-9 to G-10, G-9 to H-9, G-9 to G-8. Rows show measurements and recorded references (Meas., G.L.O., W.P.A., Plat L66 P6, W.C.R.C.).

C. Description of monument for corner and accessories established to perpetuate locating the position of the corner:

G-9 Corner of Sections 21, 22, 27 and 28, T-3-S., R-10-E.

I placed a remonumentation aluminum cap #37281 on a 1/2" iron drilled into concrete N. 65° W., 1.18 feet from existing monument in monument box at the intersection of Racho & Northline Roads and it is accepted as a careful and faithful perpetuation of the position of the original corner:

Witnesses:

AZ 110° 48' 30" 121.45 feet Cut cross northwest bolt of strain pole.
AZ 209° 42' 05" 76.61 feet Cut cross northwest bolt of strain pole.
AZ 29° 43' 20" 44.97 feet Cut cross northwest bolt of strain pole.
AZ 51° 30' 30" 65.35 feet Cut cross northwest bolt of strain pole.
AZ 114° 51' 34" 1.18 feet Concrete monument in monument box.

Signed by [Signature]
Surveyor's Michigan License No. 37281

Date July 23, 1999

R LCR 12 4R 2 Pg A [Signature]

G-9
CORNER COMMON TO SECTIONS
21, 22, 27 AND 28
T-3-S R-10-E WAYNE CO.



CUTCROSS SW BOLT
STRAIN POLE

29°43'20" 44.97'

CUTCROSS
NW BOLT
STRAIN POLE

65.35' 51°30'30"

NORTHLINE ROAD

SET IRON AND
WAYNE CO. DISK
#37261 AS
ACCEPTED
CORNER

FOUND CONCRETE MONUMENT
IN MONUMENT BOX S65°E 1.19'
FROM ACCEPTED CORNER

209°42'05"
76.61'
CUTCROSS
NW BOLT
STRAIN POLE

110°48'30"
121.45'
CUTCROSS NW BOLT
STRAIN POLE

R
A
C
H
O
R
A
D

SURVEY &
RECONSTRUCTION

FEB 28 2000

SECTION