

FILE DO NOT MAIL LAND CORNER RECORDATION CERTIFICATE Filing Requirement of Act 74, Mich. P.A. 1970

MAR 02 1999

For corners in City of Wayne Located In: Taylor Twp. Corner Code #


SECTION

Table with 3 columns: Survey Type, Township/Range, and Corner Code. Includes rows for Public Land Survey, Property Controlling in Section, and Miscellaneous Property in Sec.

Compliance with ACT 345, P.A. 1990 APPROVED ON: 12-10-98 WAYNE COUNTY REMONUMENTATION PEER GROUP COMMITTEE Register of Deeds Stamp & File Number

4. Lot No. , Recorded Plat 5. Private Claims

I, John N. Redash, in a field survey on Dec. 1, 1998 do hereby state that under requirements of P.A. 74, Michigan P.A. of 1970, the corner points mentioned in lines 1 and 2 above were in conformance with regulations and rules therefore as required in the current manual of survey instructions of the United States Department of the Interior, Bureau of Land Management or by a decree of a Court of Law and/or that the corner points mentioned in lines 3, 4 and 5 above were in conformance with the rules of the Michigan Board of Land Surveyors or by a Decree of a Court of Law; established, re-established, monumented, recovered, found as expressed below:

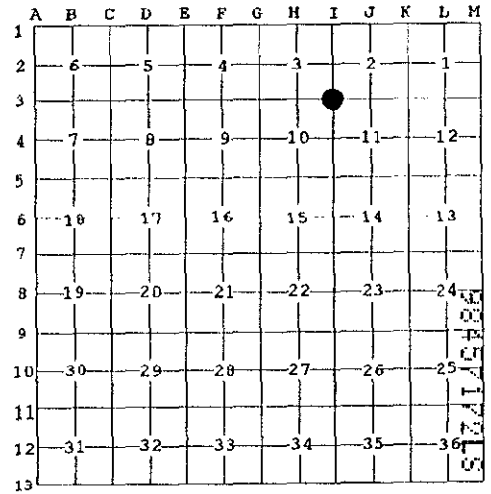

NOTE: Not more than 2 corners, all in the same town and range, may be recorded on this certificate.

A. Description of original monument and accessories and/or subsequent restoration:

- G.L.O. (1817), North 80.00 chains, set post corner Sections 3, 2, 11, 10 (description of corner not stated in notes) Witnessed as: Beech 16" S. 24° E. 20 (links) (gone) Sugar 10" N. 75° E 12 (links) (gone) W.P.A. (1930's), Iron (#31) Witnessed as: N.E. 74.47 Gas shutoff (gone) S.E. 91.35 Hydrant (relocated) S.W. 49.63 Manhole (± 49.0' to centerline manhole) N.W. 63.77 U.S.C.G.S. #6M (gone)



B. Description of corner evidence found and/or method applied in restoring or reestablishing corner:

A steel encased concrete monument with a 1" pipe in a monument box currently occupies this corner. No further witnesses are of record. Field measurements were observed between the following corners:

Table listing corner measurements and restoration details. Includes columns for corner pairs (e.g., H-3 to I-3, I-3 to I-4), measurements, and recording information (e.g., G.L.O., WPA, Plat L55, P22).

C. Description of monument for corner and accessories established to perpetuate locating the position of the corner:

I-3, Section corners 3, 2, 11, and 10. T-3-S., R-10-E., I placed a remonumentation brass cap #37281 on the existing monument in monument box at the intersection of Ecorse and Pelham Roads, and it is accepted as a careful and faithful perpetuation of the position of the original corner.

- Witnesses: N. 65° E., 69.35' Found nail and Wayne County Witness Tag N.W. face U-pole S. 20° E., 109.84' Cut cross N.E. bolt, upper flange fire hydrant S. 50° W., 72.28' Found nail and Wayne County witness tag S.E. face U-pole N. 39° W., 69/10' Cut cross N.E. bolt upper flange fire hydrant

Signed by [Signature] Date December 7, 1998 Surveyor's Michigan License No. 37281

R. LCR 7 4R 1Pg. U. DPJ