

FILE DO NOT MAIL
For corners in

LAND CORNER RECORDATION CERTIFICATE
Filing Requirement of Act 74, Mich. P.A. 1970

SECTION

Liber-30803 Page-14
99585666 12/20/1999
F.E. Youngblood, Wayne Co. Register of Deeds
DRAKNEVI

Compliance with
ACT 345, P.A. 1990
APPROVED ON: 12-7-99
WAYNE COUNTY REMONUMENTATION
PEER GROUP COMMITTEE

Register of Deeds Stamp & File Number

<u>Wayne</u> (County)	Located In: City of Taylor Township #14	Corner Code # <u>J-9</u>
1. Public Land Survey	<u>T-3-S R-10-E</u>	<u>J-9</u>
	T ___ R ___	_____
	T ___ R ___	_____
	T ___ R ___	_____
2. Property Controlling in Section	S ___ T ___ R ___	_____
	S ___ T ___ R ___	_____
3. Miscellaneous Property in Sec.	S ___ T ___ R ___	_____
	S ___ T ___ R ___	_____

4. Lot No. _____, Recorded Plat _____

5. Private Claims _____

I, John N. Redash, in a field survey on July 24, 1999 do hereby state that under requirements of P.A. 74, Michigan P.A. of 1970, the corner points mentioned in lines 1 and 2 above were in conformance with regulations and rules therefore as required in the current manual of survey instructions of the United States Department of the Interior, Bureau of Land Management or by a decree of a Court of Law and for that the corner points mentioned in lines 3, 4 and 5 above were in conformance with the rules of the Michigan Board of Land Surveyors or by a Decree of a Court of Law; established, re-established, monumented, recovered, found as expressed below:

NOTE: Not more than 2 corners, all in the same town and range, may be recorded on this certificate.

	A	B	C	D	E	F	G	H	I	J	K	L	M
1													
2		6		5		4		3		2		1	
3													
4		7		8		9		10		11		12	
5													
6		18		17		16		15		14		13	
7													
8		19		20		21		22		23		24	
9													
10		30		29		28		27		26		25	
11													
12		31		32		33		34		35		36	
13													

A. Description of original monument and accessories and/or subsequent restoration:

1817 N/A	G.L.O.	J. Fletcher	N/A	N/A
1930 ± Iron	W.P.A.	A. Champney	N/A	Wayne Co. Bureau of Taxation
1978 Fd iron in monument box	L.C.R.C.	B. Arthurs	#11358	Liber 20316 Page 845
1989 Fd iron in monument box	L.C.R.C.	R. Patterson	#17631	Liber 24457 Page 212

B. Description of corner evidence found and/or method applied in restoring or reestablishing corner:

A found 1/2" iron in monument box at the intersection of Northline and Reek Road currently occupies this corner. The following witness ties were used to recover and verify this corner's position: 4 ties match L.C.R.C. Liber 24457, Page 212.

The following distances were observed between the following corners:

I-9 to J-9	J-9 to J-10	J-9 to K-9
2626.59 Meas.	2635.58 Meas.	\$9.00 DEED
2635.38 Rec. G.L.O.	No G.L.O.	2631.79 Meas. Receipt #19151
2626.45 W.P.A.	2639.20 Plat Liber 72, Page 46	2635.38 Rec. G.L.O.
2625.91 W.P.A.		2632.21 W.P.A. FOREST E. YOUNGBLOOD, REGISTER OF DEEDS
		2631.83 W.P.A.


\$4.00 REMONUMENTATION

C. Description of monument for corner and accessories established to perpetuate locating the position of the corner:

I placed a remonumentation aluminum cap #37281 on the existing iron in monument box at the intersection of Northline and Reek Roads and it is accepted as a careful and faithful perpetuation of the position of the original corner.

Witnesses are as follows:

N 20° E	107.57 feet	Northwest bolt light pole
S 40° E	71.12 feet	Southwest bolt light pole
S 40° W	71.13 feet	Southeast bolt light pole
N 40° W	128.70 feet	Northeast bolt light pole

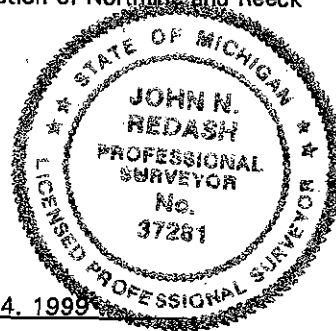

Signed by [Signature] Date July 24, 1999
Surveyor's Michigan License No. 37281