

\$ 4.00 REMONUMENTATION

\$ 7.00 DEED

7 DEC 95 11:02 A.M.

RECEIPT

RECORDED

FOREST E. YOUNGBLOOD, REGISTER  
WAYNE COUNTY, MI

Compliance with  
ACT 345, P.A. 1990

APPROVED ON: 12-4-95  
WAYNE COUNTY REMONUMENTATION  
PEER GROUP COMMITTEE

Register of Deeds Stamp & File Number

For corners in

APR 05 1996

WAYNE COMMISSION  
(County)

Located in: Corner Code #

CITY OF SOUTHGATE  
(TOWNSHIP OF TAYLOR #14)

- |                                       |     |      |      |
|---------------------------------------|-----|------|------|
| 1. Public Land Survey                 | T3S | R10E | J-11 |
|                                       | T   | R    |      |
|                                       | T   | R    |      |
|                                       | T   | R    |      |
| 2. Property Controlling in Section    | S   | T    | R    |
|                                       | S   | T    | R    |
| 3. Miscellaneous Property in Sec.     | S   | T    | R    |
|                                       | S   | T    | R    |
| 4. Lot No. _____, Recorded Plat _____ |     |      |      |
| 5. Private Claims _____               |     |      |      |

	A	B	C	D	E	F	G	H	I	J	K	L	M
2	6			5		4		3		2		1	
3													
4	7			8		9		10		11		12	
5													
6	18			17		16		15		14		13	
7													
8	19			20		21		22		23		24	
9													
10	30			29		28		27		26		25	
11													
12	31			32		33		34		35		36	
13													

I, WALTER J. ZBIKOWSKI, in a field survey on OCTOBER 17, 1995, do hereby certify that under requirements of P.A. 75, Michigan P.A. of 1970, the corner points mentioned in lines 1 and 2 above were in conformance with regulations and rules therefore as required in the current manual of survey instructions of the United States Department of the Interior, Bureau of Land Management or by a decree of a Court of Law and/or that the corner points mentioned in lines 3, 4 and 5 above were in conformance with the rules of the Michigan Board of Land Surveyors or by a Decree of a Court of Law; established, re-established, monumented, re-monumented, recovered, found as expressed below.


NOTE: Not more than 4 corners, all in the same town and range, may be recorded on this certificate.

A. Description of original monument and accessories and/or subsequent restoration.

ORIGINAL GOVERNMENT SURVEY BY JOSEPH FLETCHER, D.S. (1815-1819)  
G.L.O. (1819) SET 1/4 SEC COR (DESCRIPTION OF CORNER NOT STATED IN NOTES)  
WITNESSES: SUG 12 S 47 E 11 (7.26' REC) (GONE)  
HICKY 12 S 2 E 49 (32.34' REC) (GONE)

RESURVEY AT THE DIRECTION OF ALBERT E. CHAMPNEY, DIRECTOR OF WAYNE COUNTY BUREAU OF TAXATION

W.P.A. (1930s) IRON N-35 (#134)  
WITNESSES: NE 37.44' ED. POLE (GONE)  
SW 47.03' ED. POLE (GONE)  
NW 48.04' 10" MAPLE (GONE)  
NNW 46.12' 22" OAK (GONE)

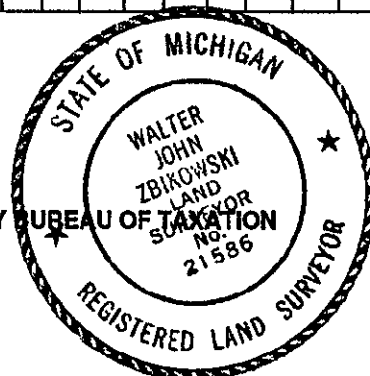

B. Description of corner evidence found and/or method applied in restoring or reestablishing corner.

FOUND A 1/2" REBAR IN A ROAD BOX (GOOD) AT THE INTERSECTION OF EUREKA AND REECK ROADS (BOTH CONCRETE PAVEMENT)  
DISTANCE TO I-11 MEASURED AS 2631.85'; RECORD G.L.O. (1816) DISTANCE OF 40.03 CHAINS (2641.98'); RECORD W.P.A. (1930s) DISTANCE OF 2631.37'  
DISTANCE TO K-11 MEASURED AS 2644.98'; RECORD G.L.O. (1816) DISTANCE OF 40.03 CHAINS (2641.98'); RECORD W.P.A. (1930s) DISTANCE OF 2644.68'  
DISTANCE TO J-12 MEASURED AS 2648.88'; RECORD W.P.A. (1930s) DISTANCE OF 2648.85'; "PARKLAND SUBDIVISION" L. 58 P. 33 (1925) RECORD DISTANCE OF 2649.26'  
DISTANCE TO J-10 MEASURED AS 2622.26'; RECORD W.P.A. (1930s) DISTANCE OF 2622.09';  
L. 19920 P. 917 FOUND IRON PIPE IN HANDHOLE (1977) LCRC #543  
N.E. 59.25' NAIL (P.K.) IN WEST (S.E.) SIDE OF POWER AND TELEPHONE POLE (MEASURED 59.46')  
S.E. 42.42' NAIL IN N.E. SIDE OF POWER AND TELEPHONE POLE (GONE)  
S.W. 40.07' NAIL IN N.W. SIDE OF TELEPHONE POLE (GONE)  
N.W. 60.00' NAIL (P.K.) IN S.W. SIDE OF GUY WIRE SUPPORT POLE (MEASURED 60.10')  
L. 25491 P. 423 PIN IN MONUMENT BOX (1991) LCRC #1023  
N.32°W. 60.08' (LARGE PROTRUDING P.K. NAIL N.E. SIDE) POWER POLE (MEASURED 60.08')  
N.30°E. 59.48' (LARGE PROTRUDING P.K. NAIL S.E. SIDE) POWER POLE (MEASURED 59.50')  
S.34°E. 58.43' (LARGE PROTRUDING P.K. NAIL N.E. SIDE) POWER POLE (MEASURED 58.46')  
S.45°W. 77.45' (LARGE PROTRUDING P.K. NAIL S.E. SIDE) POWER POLE (MEASURED 77.49')

C. Description of monument for corner and accessories established to perpetuate locating the position of the corner.

J-11 1/4 CORNER FOR SECTIONS 26, 35 T.3S, R.10E.  
A 1/2" REBAR IN A ROAD BOX (GOOD) AT THE INTERSECTION OF EUREKA AND REECK ROADS (BOTH CONCRETE PAVEMENTS) AND IT IS A CAREFUL AND FAITHFUL PERPETUATION OF THE POSITION OF THE ORIGINAL CORNER  
WITNESSES: N.30°24'E. 59.46' FOUND PLAIN P.K. NAIL IN S.E. SIDE OF A UTILITY POLE (SUPRA)  
S.34°01'E. 58.24' FOUND PLAIN P.K. NAIL IN N.E. SIDE OF A UTILITY POLE  
S.46°05'W. 77.60' FOUND PLAIN P.K. NAIL IN N.W. SIDE OF A UTILITY POLE  
N.32°21'W. 60.10' FOUND PLAIN P.K. NAIL IN S.W. SIDE OF A UTILITY POLE (SUPRA)  
PLACED A REMONUMENTATION BRASS DISC AND PVC CAP #21586 ON ABOVE FOUND 1/2" REBAR J-11.

Signed by Walter J. Zbikowski Date DEC 6, 1995  
WALTER J. ZBIKOWSKI  
Surveyor's Michigan License No. 21586

4