

FEB 20 1994

COMMISSION

LAND CORNER RECORDATION CERTIFICATE
Filing Requirement of Act 74, Mich. P.A. 1970

For corners in

WAYNE (County) Located in: CITY OF SOUTHGATE Corner Code # K-9
1. Public Land Survey T 3S R 10E
2. Property Controlling in Section S T R
3. Miscellaneous Property in Sec. S T R

Compliance with ACT 345, P.A. 1990
APPROVED ON: 11-30-93 J.P.L.
WAYNE COUNTY REMONUMENTATION PEER GROUP COMMITTEE

Register of Deeds Stamp & File Number

4. Lot No. , Recorded Plat
5. Private Claims

Grid table with columns A-M and rows 2-13. A dot is present at the intersection of column J and row 9.

I, E. PATRICK O'ROURKE, in a field survey on NOVEMBER 30, 19 93, do hereby certify that under requirements of P.A. 74, Michigan P.A. of 1970, the corner points mentioned in lines 1 and 2 above were in conformance with regulations and rules therefore as required in the current manual of survey instructions of the United States Department of the Interior, Bureau of Land Management or by a decree of a Court of Law and/or that the corner points mentioned in lines 3, 4 and 5 above were in conformance with the rules of the Michigan Board of Land Surveyors or by a Decree of a Court of Law; established, re-established, monumented, re-monumented, recovered, found as expressed below:

NOTE: Not more than 4 corners, all in the same town and range, may be recorded on this certificate.

A. Description of original monument and accessories and/or subsequent restoration:

G.L.O. (1815-1816) DESCRIPTION OF MONUMENT NOT STATED IN NOTES.
WITNESS: W. ASH 9" DIAM. COR. TREE (GONE)

W.P.A. (1930's) WITNESSES: TEL POLE NW 90.82 (GONE)
TEL POLE N 71.96 (GONE)
TEL POLE NE 96.65 (GONE)
TEL POLE S 28.64 (GONE)
3" ELM SW 88.60 (GONE)

L.C.R.C. 410 L.19055 P.863 (3-19-75)
CS 1085 L.19061 P.650 (3-25-75)
L.C.R.C. 548 L.19940 P.441 (7-2-77)
CS 1523 L.20316 P.836-837 (10-17-78)
L.C.R.C. 632 L.20316 P.845 (10-17-78)
L.C.R.C. 869 L.22742 P.809 (4-11-86)

B. Description of corner evidence found and/or method applied in restoring or reestablishing corner:

DISTANCE TO J9 MEASURED AS 2631.75'; RECORD W.P.A. (1930) DISTANCES OF 2632.21' AND 2631.83';
DISTANCE TO L9 MEASURED AS 2621.29'; RECORD W.P.A. (1930) DISTANCES OF 2632.21' AND 2620.83';

L.19055 P.863 - FOUND CONCRETE MONUMENT IN HANDHOLE (1975)
NORTH 72.20' P.K. NAIL E. SIDE AT&T POLE (GONE)
N. 65°E 75.45' TOP NUT ON HYDRANT (MEAS. 75.44')
S. 55°E 61.90' P.K. NAIL N. SIDE D.E. POLE (GONE)
S. 1°W 28.38' P.K. NAIL W. SIDE AT&T POLE (GONE)

L.19061 P.650 (C.S.) - FOUND CONC. MON. (1975)
SAME WITNESSES AS L.19055 P.863 ABOVE
(CONTINUED ON OTHER SIDE)


C. Description of monument for corner and accessories established to perpetuate locating the position of the corner:

K-9 SECTION CORNER 23, 24, 25, & 26, T.3S, R10E.
FOUND A CONCRETE MONUMENT IN A HANDHOLE ROAD BOX AT NORTHLINE AND MCCANN ROADS AND IT IS ACCEPTED AS A CAREFUL AND FAITHFUL PERPETUATION OF THE POSITION OF THE ORIGINAL CORNER.
WITNESSES: N 67°38' E 114.02' FOUND A TAGGED NAIL IN NW SIDE OF A UTILITY POLE (SUPRA)
S 69°04' E 137.55' FOUND A TAGGED NAIL IN N SIDE OF A UTILITY POLE (SUPRA)
S 43°32' W 72.19' FOUND A TAGGED NAIL IN NW SIDE OF A UTILITY POLE (SUPRA)
N 49°00' W 73.93' FOUND A TAGGED NAIL IN SW SIDE OF A UTILITY POLE (SUPRA)

PLACED A REMONUMENTATION BRASS TAG AND CAP #16937 ON ABOVE FOUND MONUMENT K9

Signed by [Signature]
E. PATRICK O'ROURKE
Surveyor's Michigan License No. 16937

Date NOVEMBER 30, 1993

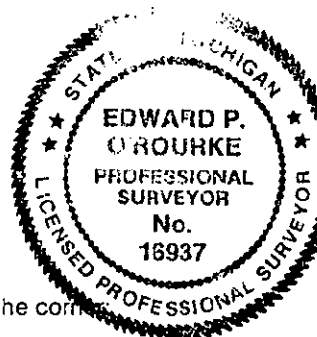

12/13/93 35696 REMO FEE 2.00  
 12/13/93 35696 DEED 14.00

FILE DO NOT MAIL

SECTION B (CONTINUED)

L.19940 P.441 - FOUND HANDHOLE (1977)

N. 32°W 73.30' FACE OF WOOD POLE (MEAS. 73.45')  
 SOUTH 10.80' EDGE OF PAVEMENT, NORTHLINE ROAD (93' WD) (GONE)  
 NORTH 11.25' EDGE OF PAVEMENT, NORTHLINE ROAD (93' WD) (GONE)

L.20316 P.836-837 (CS) - FOUND W.C.R.C. HANDHOLE MON. (1978)

NE'LY 75.47' TOP CENTER OF HYD. (MEAS. 75.44')  
 NE'LY 113.83' P.K. NAIL W. SIDE OF MBT POLE (MEAS. 113.71')  
 SE'LY 137.09' P.K. NAIL W. SIDE OF D.E. CO. POLE (MEAS. 137.02')  
 SW'LY 72.13' P.K. NAIL E. SIDE OF D.E. CO. POLE (MEAS. 71.86')

L.20316 P.845 - FOUND W.C.R.C. HANDHOLE MONUMENT (1978)

SAME WITNESSES AS L.20316 P.836-837 ABOVE.

L.22742 P.809 - FOUND CONCRETE MONUMENT IN A HANDHOLE (1986)

N. 70°E 114.16' TAGGED NAIL IN NW SIDE OF UTILITY POLE (MEAS. 114.02')  
 S. 65°E 137.55' TAGGED NAIL IN NW SIDE OF UTILITY POLE (MEAS. 137.55')  
 S. 40°W 72.32' TAGGED NAIL IN NW SIDE OF UTILITY POLE (MEAS. 72.19')  
 N. 45°W 73.73' TAGGED NAIL IN E SIDE OF UTILITY POLE (MEAS. 73.98')