

LAND CORNER RECORDATION CERTIFICATE
Filing Requirement of Act 74, Mich. P.A. 1970

For corners in

WAYNE (County)	Located In: CITY OF SOUTHGATE	Corner Code #
1. Public Land Survey	T <u>35</u> R <u>10E</u>	K-13
	T _____ R _____	_____
	T _____ R _____	_____
	T _____ R _____	_____
2. Property Controlling in Section	S _____ T _____ R _____	_____
	S _____ T _____ R _____	_____
3. Miscellaneous Property in Sec.	S _____ T _____ R _____	_____
	S _____ T _____ R _____	_____

Compliance with
 ACT 345, P.A. 1990
 APPROVED ON: 11-30-93
 WAYNE COUNTY REMONUMENTATION
 PEER GROUP COMMITTEE

Register of Deeds Stamp & File Number

4. Lot No. _____, Recorded Plat _____
 5. Private Claims _____

	A	B	C	D	E	F	G	H	I	J	K	L	M
2	6	5	4	3	2	1							
3													
4	7	8	9	10	11	12							
5													
6	13	17	16	15	14	13							
7													
8	19	20	21	22	23	24							
9													
10	30	29	28	27	26	25							
11													
12	31	32	33	34	35	36							
13													

I, E. PATRICK O'ROURKE, in a field survey on NOVEMBER 30, 19 93, do hereby certify that under requirements of P.A. 74, Michigan P.A. of 1970, the corner points mentioned in lines 1 and 2 above were in conformance with regulations and rules therefore as required in the current manual of survey instructions of the United States Department of the Interior, Bureau of Land Management or by a decree of a Court of Law and/or that the corner points mentioned in lines 3, 4 and 5 above were in conformance with the rules of the Michigan Board of Land Surveyors or by a Decree of a Court of Law; established, re-established, monumented, re-monumented, recovered, found as expressed below:

NOTE: Not more than 4 corners, all in the same town and range, may be recorded on this certificate.

A. Description of original monument and accessories and/or subsequent restoration:

G.L.O. (1815-1816) DESCRIPTION OF MONUMENT NOT STATED IN NOTES.

WITNESSES: WO 12" S 49 W 14 (9.24') (GONE)

DO 12" S 25 E 26 (17.16') (GONE)

L.C.R.C. #382 L.18997 P.803

W.P.A. (1930's) WITNESSES: CROSS ON STONE NW 28.15' (GONE)

L.C.R.C. #625 L.20279 P.380

(STAKE OVER STONE) FENCE POST NE 40.75' (GONE)

IRON E 135.30' (MEAS. 135.33')

#159 TEL POLE SE 94.67' (GONE)

TEL POLE SW 34.95' (GONE)

TEL POLE NW 72.43' (GONE)

B. Description of corner evidence found and/or method applied in restoring or reestablishing corner:

DISTANCE TO L13 MEASURED AS 2597.90'; RECORDED (1930) W.P.A. DISTANCE OF 2597.95';

L.18997 P.803 - FOUND CONCRETE MONUMENT IN BOX (1974)


N.W. 88.55' "X" CUT IN S.W. BOLT HEAD OF SERVICE STATION LIGHT FOUNDATION (MEAS. 88.56')

N.E. 71.97' "X" CUT IN WEST RIM OF NORTHERLY GAS MANHOLE CASTING (MEAS. 71.99')

S.E. 98.63' SPIKE WITH BRASS TAG IN S.W. SIDE OF MICH. BELL POLE (MEAS. 98.69')

S.W. 65.70' SPIKE WITH BRASS TAG IN E. SIDE OF MICH. BELL POLE (GONE)

(CONTINUED ON OTHER SIDE)

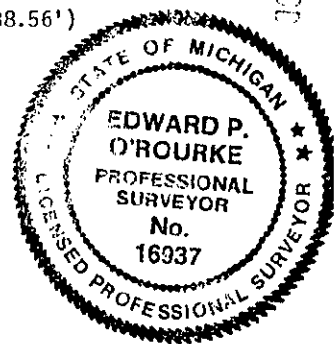

C. Description of monument for corner and accessories established to perpetuate locating the position of the corner:

K-13 SECTION CORNER 35 & 36, T3S, R10E.

FOUND A 1/2" IRON ROD IN A HANDHOLE ROAD BOX AT PENNSYLVANIA AND MCCANN ROADS AND IT IS ACCEPTED AS A CAREFUL AND FAITHFUL PERPETUATION OF THE POSITION OF THE ORIGINAL CORNER.

WITNESSES: N 46°27'W 88.56' FOUND C/L SW BOLT IN GAS STATION LIGHT FOUNDATION (SUPRA)

N 47°42'E 46.40' FOUND NAIL IN BRASS TAG ON SE SIDE OF D.E. POLE (SUPRA)

S 44°35'E 46.80' FOUND "X" CUT IN NW CORNER OF CONC. BASE TO TRAFFIC SIGNAL FOUNDATION (SUPRA)

S 23°05'W 37.26' SET NAIL IN SHINER ON SE SIDE OF MBT POLE

PLACED A REMONUMENTATION BRASS TAG AND CAP #16937 ON ABOVE FOUND 1/2" IRON ROD K-13.

Signed by E. Patrick O'Rourke
 Surveyor's Michigan License No. 16937

Date NOVEMBER 30, 1993

12/13/93 35696 DEED 14.00
12/13/93 35696 REMO FEE 2.00

12/13/93 35696 DEED 14.00
12/13/93 35696 REMO FEE 2.00

SECTION B (CONTINUED)

- L.20279 P.340 - FOUND CONCRETE MONUMENT IN MONUMENT BOX (1978)
- NW 88.55 "X" CUT IN SW BOLT HEAD IN SERVICE STATION LIGHT FOUNDATION (MEAS. 88.56')
- NE 46.44 NAIL IN BRASS TAG IN SE/S D.E. POLE (MEAS. 46.40')
- SE 46.85 "X" CUT ON NW CORNER OF TRAFFIC SIGNAL FOUNDATION (MEAS. 46.80')
- SW 36.93 NAIL IN BRASS TAG IN SE/S MBT POLE (GONE)
- NW 51.52 "X" CUT IN SE/ OF "SHELL" CONCRETE SIGN FOUNDATION (MEAS. 51.56')
- E 135.39 NW CORNER OF SEC. 1, T.4S, R.10E., (MEAS. 135.33')

NO OTHER L.C.R.C. RECORDS AT WAYNE COUNTY REGISTER OF DEEDS.