

RF

FEB 28 2000

FILE DO NOT MAIL

LAND CORNER RECORDATION CERTIFICATE  
Filing Requirement of Act 74, Mich. P.A. 1970

SECTION

For corners in

Wayne Located In: City of \_\_\_\_\_ Corner Code # \_\_\_\_\_  
(County) River Rouge

1. Public Land Survey T \_\_\_\_\_ R \_\_\_\_\_  
T \_\_\_\_\_ R \_\_\_\_\_  
T \_\_\_\_\_ R \_\_\_\_\_  
T \_\_\_\_\_ R \_\_\_\_\_

2. Property Controlling S \_\_\_\_\_ T \_\_\_\_\_ R \_\_\_\_\_  
in Section S \_\_\_\_\_ T \_\_\_\_\_ R \_\_\_\_\_

3. Miscellaneous S \_\_\_\_\_ T \_\_\_\_\_ R \_\_\_\_\_  
Property in Sec. S \_\_\_\_\_ T-3-S R-11-E # 8

Liber-30803 Page-12  
99585660 12/20/1999  
F.E. Younblood, Wayne Co. Register of Deeds

Compliance with  
ACT 345, P.A. 1990

APPROVED ON: 12-7-99 *DB*  
WAYNE COUNTY REMONUMENTATION  
PEER GROUP COMMITTEE

Receipt #19151  
Register of Deeds Stamp & File Number

FOREST E. YOUNGBLOOD, REGISTER OF DEEDS  
WAYNE COUNTY, MI

4. Lot No. \_\_\_\_\_, Recorded Plat \_\_\_\_\_

5. Private Claims Intersection of the easterly line of P.C. 497 and the westerly line of P.C. 496 at the centerline of Alexander Avenue and Great Lakes Avenue.

I, John N. Redash, in a field survey on December 5, 1999 do hereby state that under requirements of P.A. 74, Michigan P.A. of 1970, the corner points mentioned in lines 1 and 2 above were in conformance with regulations and rules therefore as required in the current manual of survey instructions of the United States Department of the Interior, Bureau of Land Management or by a decree of a Court of Law and/or that the corner points mentioned in lines 3, 4 and 5 above were in conformance with the rules of the Michigan Board of Land Surveyors or by a Decree of a Court of Law; established, re-established, monumented, recovered, found as expressed below:

NOTE: Not more than 2 corners, all in the same town and range, may be recorded on this certificate.

	A	B	C	D	E	F	G	H	I	J	K	L	M
1													
2	6		5		4		3		2		1		
3													
4	7		8		9		10		11		12		
5													
6	18		17		16		15		14		13		
7													
8	19		20		21		22		23		24		
9													
10	30		29		28		27		26		25		
11													
12	31		32		33		34		35		36		
13													



A. Description of original monument and accessories and/or subsequent restoration:

Aaron Greely original Surveyor of private claims description of Private Claim 1809.

B. Description of corner evidence found and/or method applied in restoring or reestablishing corner:


No evidence of corner found. Determined position of point on Private Claim Line 497 and 496 at the intersection of Great Lakes Avenue and Alexander Avenue from establishment of monumentation within two blocks of "Chas. A. Visgers Subdivision" as recorded in Liber 27, Page 81, Wayne County Records. Supporting documentation and analysis of evidence is in the research dossier on file at Wayne County Register of Deeds.

C. Description of monument for corner and accessories established to perpetuate locating the position of the corner:

I placed a 1/2" iron rod with a 2" diameter aluminum disk stamped "Wayne County Remonumentation #37281" in a monument box at the intersection of Alexander and Great Lakes Avenue.

Witnesses are as follows:

- AZ 131° 24' 30" 101.83 feet Mag nail and W.C.R. Tag in northwest face of utility pole
- AZ 95° 46' 34" 62.07 feet Mag nail and W.C.R. Tag in northwest face of utility pole
- AZ 322° 35' 46" 56.41 feet Mag nail and W.C.R. Tag in northeast face of utility pole
- AZ 251° 20' 02" 29.97 feet Mag nail and W.C.R. Tag in northwest face of utility pole.

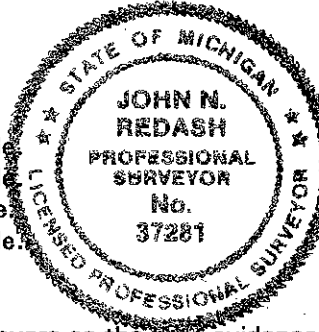

The location of this corner is accepted by myself and is generally accepted by professional surveyors as the best evidence of the position of the original Private Claim Line.

Signed by *John N. Redash*  
Surveyor's Michigan License No. 37281

\$4.00 REMONUMENTATION  
\$3.00 DEED  
Date December 15, 1999

*R LCR 9 4R 1B A DB*