

A-13 IS COMMON TO CORNER A OF PEE ORIGINAL NOTES AND 1930'S SURVEY WORK.

RC 1567

\$ 16.00 MISCELLANEOUS RECORDING
 28 DEC 94 8:21 A.M. RECEIPT# 129
 RECEIVED
 WEST E. YORKSHIRE, TOWNSHIP OF BELLS
 WAYNE COUNTY, MI

LAND CORNER RECORDATION CERTIFICATE

Filing Requirement of Act 74, Mich. P.A. 1970

For corners in

<u>Wayne</u> (County)	Located In:	Corner Code #
1. Public Land Survey	T 3 S R 8 E T <u>4 S</u> R <u>8 E</u>	<u>A-13</u> <u>AO1 ✓</u>
2. Property Controlling in Section	S _____ T _____ R _____ S _____ T _____ R _____	_____
3. Miscellaneous Property in Sec.	S _____ T _____ R _____ S _____ T _____ R _____	_____
4. Lot No. _____, Recorded Plat _____		
5. Private Claims _____		

L127800PA058

Compliance with ACT 345, P.A. 1990

APPROVED ON: 12-8-94 *DBJ*
 WAYNE COUNTY REMONUMENTATION
 PEE GROUP COMMITTEE

Register of Deeds Stamp & File Number

RC 1567

I, William L Roskelly in a field survey on November 1, 19 94, do hereby certify that under requirements of P.A. 74, Michigan P.A. of 1970, the corner points mentioned in lines 1 and 2 above were in conformance with regulations and rules therelore as required in the current manual of survey instructions of the United States Department of the Interior, Bureau of Land Management or by a decree of a Court of Law and/or that the corner points mentioned in lines 3, 4 and 5 above were in conformance with the rules of the Michigan Board of Land Surveyors or by a Decree of a Court of Law; established, re-established, monumented, re-monumented, recovered, found as expressed below:

	A	B	C	D	E	F	G	H	I	J	K	L	M
2	6		5		4		3		2		1		
3													
4	7		8		9		10		11		12		
5													
6	18		17		16		15		14		13		
7													
8	19		20		21		22		23		24		
9													
10	30		29		28		27		26		25		
11													
12	31		32		33		34		35		36		
13													

NOTE: Not more than 4 corners, all in the same town and range, may be recorded on this certificate.

A. Description of original monument and accessories and/or subsequent restoration:

A-13) Southwest Corner Section 31, T.3 S.,R.8 E.

G.L.O. (1830's) set corner post Witnesses: Walnut 12N. 68E. (gone) Ash 12S. 69W. 14 (gone)
 W.P.A. (1930's) found monument at corner, Witnesses:

- N.W. 26.05 Edison guy pole (gone) S.E. 35.68 fence post (gone)
- N.W. 27.08 Edison guy pole (gone) S.W. 61.32 12" box elder (gone)
- N.E. 38.17 Edison guy pole (gone) S.W. 41.80 U.S.G.S. Monument(not found)

(continued to page 2)

B. Description of corner evidence found and/or method applied in restoring or reestablishing corner:

A-13) Southwest Corner Section 31, T.3 S.,R.8 E.

Found steel bar in concrete monument in monument box at Bemus and Rawsonville Roads. The distances and angles were measured and compared to the W.P.A. recorded measurements as follows:

- A-13 to A-12: M. = 2688.22 W.P.A. = 2688.74
- A-13 to B-12: M. = 2709.86 W.P.A. = 2709.61
- Angle line A-13 - A-12 to line A-13 - B-12: M. = 89° 54' 23" W.P.A. 89° 53' 20"
- Concrete monument with steel bar, Washtenaw County
- A-13 to monument N. 2650.98'


C. Description of monument for corner and accessories established to perpetuate locating the position of the corner:

A-13) Southwest Corner Section 31, T.3 S.,R.8 E.

Found steel bar in concrete monument in monument box at Bemus & Rawsonville Road. The selected location is accepted by the Contractor and is generally accepted by professional surveyors as the best available evidence of the position of the original corner.
 Found P.K. and tag OHM KSW 21584 S.E. face P. pole N.50° E. Dist.=73.22
 Found nail and tag W.C.R.C. S.E. face power pole N.50° E. Dist.=73.36 Rec.73.35
 Found P.K. and tag OHM KSW 21584 S.E. face p. pole S.22° W. Dist.=77.42
 Set nail and W.C.R. tag South face P. pole N.65° W. Dist.=96.68
 Placed Wayne County Remonumentation brass marker with cap # 10705

2 R
 14-D
 MISC

Signed by *William L Roskelly* Date 12/27/94
 Surveyor's Michigan License No. 10705

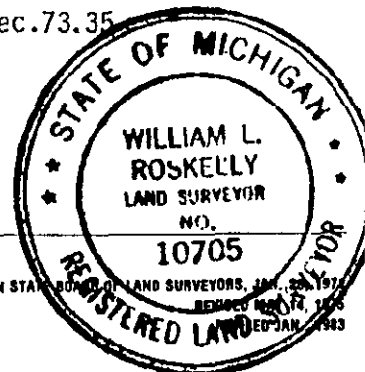

FORM APPROVED BY MICHIGAN STATE BOARD OF LAND SURVEYORS, JAN. 28, 1971