

FEB 28 1994

COMMISSION

LAND CORNER RECORDATION CERTIFICATE  
Filing Requirement of Act 74, Mich. P.A. 1970

L127042PA378

For corners in

Wayne  
County:  
SUMPTER TOWNSHIP

Located in: Corner Code #

1. Public Land Survey T 4 S R 8 E A-03  
T \_\_\_\_\_ R \_\_\_\_\_  
T \_\_\_\_\_ R \_\_\_\_\_  
T \_\_\_\_\_ R \_\_\_\_\_

2. Property Controlling S \_\_\_\_\_ T \_\_\_\_\_  
in Section S \_\_\_\_\_ T \_\_\_\_\_ R \_\_\_\_\_

3. Miscellaneous S \_\_\_\_\_ T \_\_\_\_\_  
Property in Sec. S \_\_\_\_\_ T \_\_\_\_\_ R \_\_\_\_\_

4. Lot No. \_\_\_\_\_ Recorded Plat \_\_\_\_\_

5. Private Claims \_\_\_\_\_

Compliance with  
ACT 345, P.A. 1990

APPROVED ON: 12-15-93  
WAYNE COUNTY REMONUMENTATION  
PEER GROUP COMMITTEE

Register of Deeds Stamp & File Number

RC 1356

I, Kenneth S. Wilkerson, in a field survey on October 04, 19 93, do hereby certify that under requirements of P.A. 74, Michigan P.A. of 1970, the corner points mentioned in lines 1 and 2 above were in conformance with regulations and rules therefore as required in the current manual of survey instructions of the United States Department of the Interior, Bureau of Land Management or by a decree of a Court of Law and/or that the corner points mentioned in lines 3, 4 and 5 above were in conformance with the rules of the Michigan Board of Land Surveyors or by a Decree of a Court of Law, established, re-established, monumented, re-monumented, recovered, found as expressed below:

NOTE: Not more than 4 corners, all in the same town and range, may be recorded on this certificate.

A. Description of original monument and accessories and/or subsequent restoration:

A-03 Set Post - GLO - NO GLO WITNESSES REMAIN  
Fd. Iron - B of T  
Mon. in Mon. Box - WCRC (09/70)  
  
Fd. mon in mon box L. 18340 P. 686

N 20 E 69.90 PK in W side PP  
S 50 E 76.10 SE cor steps  
S 50 W 42.80 PK in NW side PP  
N 60 W 46.90 PK in S side MBT P

B. Description of corner evidence found and/or method applied in restoring or reestablishing corner:

A-03 Fd 1/2" Iron rod in mon box  
  
Verified by three witnesses per L. 18340, P. 686

C. Description of monument for corner and accessories established to perpetuate locating the position of the corner:

Set Wayne County remonumentation washer and OHM - KSW 21584 cap on iron  
  
A-03 013 az 69.69 fd PK in SE face MBT P  
134 az 72.45 NW cor block bldg  
224 az 42.84 PK & tag SE face PP  
307 az 46.89 PK & tag NE face MBT P

The selected location is accepted as the best evidence of the position of the original corner.

Signed by: [Signature]


Date: Nov 15 1993

Drafted By: Kenneth S. Wilkerson  
Surveyor's Michigan License No. 21584

Orchard, Hiltz & McCliment, Inc.  
34935 Schoolcraft Road \* Livonia, Michigan 48150 \* Phone: (313) 522-6711

A	B	C	D	E	F	G	H	I	J	K	L	M
2	6	5	4	3	2	1						
3												
4	7	8	9	10	11	12						
5												
6	18	17	16	15	14	13						
7												
8	19	20	21	22	23	24						
9												
10	30	29	28	27	26	25						
11												
12	31	32	33	34	35	36						
13												

93 DEC 15 PM 5:00  
FOREST E. YOUNGBLOOD  
REGISTER OF DEEDS  
WAYNE COUNTY, MI

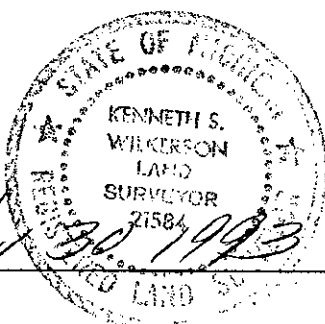

2R  
11KD