FILE DO NOT WAILAND CORNER RECORDATION CERTIFICATE Filing Requirement of Act 74, Mich. P.A. 1970


WAYNE	Located In:	Corner Code #
(County)	SUMPTER TWP.	
1. Public Land Survey	T 4S R 8E	A-13
	TR	
	T R	
	TR	
2. Property Controlling	S T R	
in Section	S T R	
3. Miscellaneous	S T R	
Property in Sec.	S TR	

SECTION Liber-30836 Page-42 99590856 12/23/1999 F.E. Youngblood, Wayne Co. Register of Deeds RDANDSYL Compliance with

ACT 345, P.A. 1990

APPROVED ON: 12-10-99 WAYNE COUNTY REMONUMENTATION PEER GROUP COMMITTEE

Register of Deeds Stamp & File Number

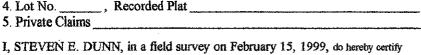

that under requirements of P.A. 74, Michigan P.A. of 1970, the comer points mentioned in lines 1 and 2 above were in conformance with regulations and rules therefore as required in the current manual of survey instructions of the United States Department of the Interior, Bureau of Land Management or by a decree of a Court of Law and /or that the corner points mentioned in lines 3, 4 and 5 above were in conformance with the rules of the Michigan Board of Land Surveyors or by a Decree of a Court of Law; established, re-established, monumented, re-monumented, recovered, found as expressed below:

NOTE: Not more than 2 corners, all in the same town and range, may be recorded on this certificate.

A. Description of original monument and accessories and/or subsequent restoration:

GLO POST-NO EVIDENCE OF ORIGINAL CORNER FOUND, SURVEYED BY ALEX HOLMES-1816

WPA RE-SURVEY OF ORIGINAL SECTIONS WAYNE COUNTY BUREAU OF TAXATION

For corners in

TIES TO SECTION CORNERS #169

3

4

5

7

8

10

11 12

13

WAYNE COUNTY BUREAU OF TAXATION WAYNE COUNTY BUREAU OF TAXATION 1/4 SECTION MAP-NW OF 31 1/4 SECTION MAP-SW OF 31 **REV. 1943 REV. 1948**

1930's

BOARD OF WAYNE COUNTY ROAD COMMISSIONERS

SECTION CORNER WITNESS RECORD

MARCH 10, 1971

DEPARTMENT OF MANAGEMENT AND BUDGET

1/4 SECTION MAP

1991

ASSESSMENT AND EQUALIZATION DIVISION

Description of corner evidence found and/or method applied in restoring or reestablishing corner: A-13 Township Corner. Corner is common with A-1, Town 5 South, Range 8 East, M-13, Town 4 South, Range 7 East, and M-1, Town 5 South, Range 7 East.

Found Iron Rod with Washtenaw County Road Commission cap stamped #37269 in Monument Box in asphalt road at centerline intersection of Rawsonville Road and Oakville-Waltz Road.

I verified the location by comparing field measurements with record measurements of WPA Re-Survey of Original Sections.

FIELD MEASUREMENTS & RECORD MEASUREMENTS:

A-13 to A-12 (Remon Corner) GLO-40 Chains (2640.00') WPA Re-Survey-2660.77' Field-2660.89

A-13 to B-13

GLO-46 Chains (3036.00') WPA Re-Survey-3107.33'

Field-3107.32

Description of monument for corner and accessories established to perpetuate locating the position of the corner:

A-13 Township comer. Corner is common with A-1, Town 5 South, Range 8 East, M-13, Town 4 South, Range 7 East, and M-1, Town 5 South, Range 7 Fast

I ACCEPTED THE IRON ROD WITH WASHTENAW COUNTY ROAD COMMISSION CAP STAMPED #37269 IN EXISTING MONUMENT BOX IN ASPHALT PAVEMENT.

WITNESSES:

40.47' Chiseled "+" on southwest rim of catch basin. 80.15' Chiseled "+" on west rim of gate valve and well. Az. 45° Az. 70° Chiseled "+" on west rim of storm manhole. Az. 145° 36.74 100.73' Northeast corner of Collision Repair building.

AVAILABLE OF MICHOLINA DE LA DELLA D THE SELECTED LOCATION IS ACCEPTED BY ME AND IS GENERALLY ACCEPTED BY PROFESSIONAL SURVEYORS AS THE BEST AVAILABLE EVIDENCE OF THE POSITION OF THE ORIGINAL CORNER.

Signed by Steven & Dunn

SURVEYOR NO. 28408 SUNVETON No. 28408 Date Dac 21

Surveyor's Michigan License No.

FORM APPROVED BY MICHIGAN STATE BOARD OF LAND SURVEYORS, JAN. 28, 1971 REVISED MAY 14,1976 REVISED JAN., 1983

RLCR 9 4R 1Pg A DP-1