

FEB 28 1994

LAND CORNER RECORDATION CERTIFICATE
Filing Requirement of Act 74, Mich. P.A. 1970

COMMISSION

LI 27042 PA 341

For corners in

Wayne

County:

SUMPTER TOWNSHIP

Located in:

Corner Code #

1. Public Land Survey	T <u>4 S</u>	R <u>8 E</u>	<u>B-03</u>
	T _____	R _____	_____
	T _____	R _____	_____
	T _____	R _____	_____
2. Property Controlling in Section	S _____	T _____	_____
	S _____	T _____	_____
3. Miscellaneous Property in Sec.	S _____	T _____	_____
	S _____	T _____	_____

Compliance with
ACT 345, P.A. 1990

APPROVED ON: 12-15-93 DOJ.

WAYNE COUNTY REMONUMENTATION
PEER GROUP COMMITTEE

Register of Deeds Stamp & File Number

RC 1319

4. Lot No. _____, Recorded Plat _____

5. Private Claims _____

I, Kenneth S. Wilkerson, in a field survey on October 04, 19 93, do hereby certify that under requirements of P.A. 74, Michigan P.A. of 1970, the corner points mentioned in lines 1 and 2 above were in conformance with regulations and rules therefore as required in the current manual of survey instructions of the United States Department of the Interior, Bureau of Land Management or by a decree of a Court of Law and/or that the corner points mentioned in lines 3, 4 and 5 above were in conformance with the rules of the Michigan Board of Land Surveyors or by a Decree of a Court of Law; established, re-established, monumented, re-monumented, recovered, found as expressed below:

NOTE: Not more than 4 corners, all in the same town and range, may be recorded on this certificate.

A. Description of original monument and accessories and/or subsequent restoration:

B-03 Set Post - GLO - NO GLO WITNESSES REMAIN
Iron - B of T
Iron in Pav't - WCRC (1/11/73)
Iron in Pav't - L. 18340, P. 686

N 20 E 69.90 PK in W face PP
S 50 E 76.10 SE cor steps
S 50 W 42.80 PK in NW face PP
N 60 W 46.90 PK in S. face MBT P

B. Description of corner evidence found and/or method applied in restoring or reestablishing corner:

B-03 Fd 5/8" iron rod

Verified by measured distances to east 2699.75 rec.
2699.61 meas.
2699.84 rec.

and west 3075.15 rec.
3073.81 meas.
3073.46 rec.

The selected location is accepted as the best evidence of the position of the original corner.

C. Description of monument for corner and accessories established to perpetuate locating the position of the corner:

Set Wayne County remonumentation washer and OHM - KSW 21584 cap on iron.


B-03 080 az 92.00 PK & tag S face MBT P
152 az 68.45 PK & tag in SW face 14" fruit tree
204 az 56.95 PK & tag in NW face 12" Elm
355 az 27.97 PK & tag W face MBT P

The selected location is accepted as the best evidence of the position of the original corner.

Signed by: [Signature]

Date: Nov 30 1993

Drafted By: Kenneth S. Wilkerson
Surveyor's Michigan License No. 21584

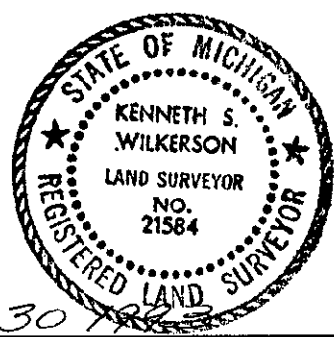

Orchard, Hiltz & McCliment, Inc.
34935 Schoolcraft Road * Livonia, Michigan 48150 * Phone: (313) 522-6711

2R
11K1

	A	B	C	D	E	F	G	H	I	J	K	L	M
2	6		5		4		3		2		1		
3	7		8		9		10		11		12		
4													
5													
6	18		17		16		15		14		13		
7													
8	19		20		21		22		23		24		
9													
10	30		29		28		27		26		25		
11													
12	31		32		33		34		35		36		
13													

RECEIVED
 FORESTER YOUNGBLOOD
 REGISTER OF DEEDS
 WAYNE COUNTY, MI
 5:59 PM 11/15/93