

LAND CORNER RECORDATION CERTIFICATE

APR 05 1996 Filing Requirement of Act 74, Mich. P.A. 1970

B-05 Page 1

For corners in **COMMISSION**

Wayne County	Located In:	Sumpter	Corner Code
1. Public Land Survey	T 4 S	R 8 E	B-05
	T	R	
	T	R	
	T	R	
2. Property Controlling in Section	S	T	R
	S	T	R
3. Miscellaneous Property in Sec.	S	T	R
	S	T	R
4. Lot No. _____, Recorded Plat _____			
5. Private Claims _____			

Compliance with ACT 345, P.A. 1990

APPROVED ON: 11-30-95 *DBJ*
WAYNE COUNTY REMONUMENTATION PEER GROUP COMMITTEE

Register of Deeds Stamp and File Number

	A	B	C	D	E	F	G	H	I	J	K	L	M
2	6	5	4	3	2	1							
3													
4	7	8	9	10	11	12							
5	●												
6	18	17	16	15	14	13							
7													
8	19	20	21	22	23	24							
9													
10	30	29	28	27	26	25							
11													
12	31	32	33	34	35	36							
13													

I, Kenneth S. Wilkerson in a field survey on 03/01/1995 do hereby certify that under requirements of P.A. 74, Michigan P.A. of 1970, the corner points mentioned in lines 1 and 2 above were in conformance with regulations and rules therefore as required in the current manual of survey instructions of the United States Department of the Interior, Bureau of Land Management, or by a decree of a Court of Law and/or that the corner points mentioned in lines 3, 4 and 5 above were in conformance with the rules of the Michigan Board of Land Surveyors or by a Decree of a Court of Law, established, re-established, monumented, re-monumented, recovered, found as expressed below.

NOTE: Not more than 4 corners, all in the same town and range, may be recorded on this certificate.

A. Description of original monument and accessories and/or subsequent restorations:
01/01/1816 Wampler G.L.O. Set post
8" R. O. S 56 W 21 LINKS (13.86') (GONE)
12" B. O. N 20 W 10 LINKS (6.66') (GONE)

(Witnesses Continued on Back ...)

B. Description of corner evidence found and/or method applied in restoring or reestablishing corner:
Fd. 1/2" iron rod in grv'l rd @ 6'N of cl of Judd Rd. Dist. to A-5 = 3089.10' (R). 3089.30' (M) & Dist to C-5 = 2658.07' (R), 2658.36' (M)

C. Description of monument for corner and accessories established to perpetuate locating the position of the corner:
03/01/1995 Wilkerson 21584 O.H.M. Remon.

- SET W.C.R. WASHER & CAP OVER 1/2" IRON ROD.
- 2 W.C.R. TAG W/P.K. NAIL IN E. SIDE 50" OAK S 10 W 34.30'
- 3 NAIL IN N.E. SIDE 22" WALNUT, S60W 49.29'
- 6 N. W. COR. HSE. #50255 S 10 E 134.28'
- 7 N. E. COR. HSE. #50325 S 20 W 109.25'
- 8 W.C.R.C. TAG IN S. W. SIDE 10" ASH N 60 W 43.24'


\$ 10.00 DEED
21 DEC 95 9:17 A.M. RECEIPT# 58
RECORDED
FOREST E. YOUNGBLOOD, REGISTER OF DEEDS
WAYNE COUNTY, MI
\$ 4.00 REMONUMENTATION

We conclude that after careful study of the record documentation and field observations, that this corner is accepted as the best available evidence of the position of the original corner.

Signed by *Kenneth S. Wilkerson*
Drafted by Kenneth S. Wilkerson
Surveyor's Michigan License No. 21584

Date DEC 21 1995

Orchard, Hiltz and McCliment, Inc. 34935 Schoolcraft Road Livonia, MI 48150

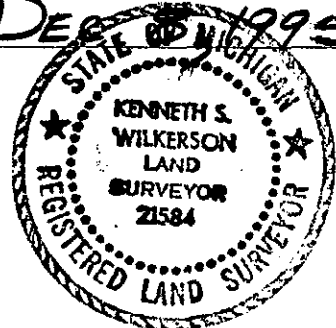

95273108

*AK
100
KS*

A. (Continued) Description of original monument and accessories and/or subsequent restorations:

01/01/1930			Wayne Co. Bureau of Taxation		Fd. iron
	1	E & W FENCE LINE NORTH 32.60' (GONE)			
	2	36" OAK SOUTHERLY 33.87'			
	3	15" WALNUT SOUTHWESTERLY 49.35'			
	4	12" MAPLE SOUTHWESTERLY 84.20'(GONE)			
	5	36" OAK NORTHWESTERLY 38.37' (GONE)			
	9	DIST = 3089.10' TO A-05 (R), 3089.30' (M-1995)			
	10	DIST = 2658.07' TO C-05 (R), 2658.36, (M-1995)			
	11	BS) A-05 FS) C-05 ANGLE = 181-23-30 (R), 181-15-13 (M-1995)			
11/01/1976		Roskelly	18863	Roskelly, Jekabson & Assoc.	Certificate Fd. 1/2" iron bar
	2	NAIL IN 48" OAK S 10 W 34.33'			
	3	NAIL IN 20" WALNUT S 60 W 49.27'			
	6	N.W. COR. HOUSE #50255 SOUTHERLY 134.23'			
	7	N.E. COR. HOUSE #30325 S 20 W 109.07'			
07/05/1977		Roskelly	18863	Roskelly, Jekabson & Assoc.	Certificate Fd. 1/2" iron bar
	2	NAIL IN 48" OAK S 10 W 34.33'			
	3	NAIL IN 20" WALNUT S 60 W 49.27'			
	6	N.W. COR. HOUSE #50255 SOUTHERLY 134.23'			
	7	N.E. COR. HOUSE #30325 S 20 W 109.07'			

LIBER 28477 PAGE 185

FILED DO NOT MAIL