

**SURVEY &
REMONUMENTATION**

RC 1623

APR 25 1995

LAND CORNER RECORDATION CERTIFICATE

LI27802PA189

Filing Requirement of Act 74, Mich. P.A. 1970

B-11 Page 1

COMMISSION

For corners in

Wayne	Located in:	Sumpter	Corner Code
County SUMPTER			B-11
1. Public Land Survey	T 4 S	R 8 E	
	T	R	
	T	R	
	T	R	
2. Property Controlling In Section	S	T	R
	S	T	R
3. Miscellaneous Property in Sec.	S	T	R
	S	T	R
4. Lot No. _____, Recorded Plat _____			
5. Private Claims _____			

Compliance with
ACT 345, P.A. 1990

APPROVED ON: 12-9-94
WAYNE COUNTY REMONUMENTATION
PEER GROUP COMMITTEE

Register of Deeds Stamp and File Number

I, Kenneth S. Wilkerson in a field survey on 11/30/1994
do hereby certify that under requirements of P.A. 74, Michigan P.A. of 1970, the corner points mentioned in lines 1 and 2 above were in conformance with regulations and rules therefore as required in the current manual of survey instructions of the United States Department of the Interior, Bureau of Land Management, or by a decree of a Court of Law and/or that the corner points mentioned in lines 3, 4 and 5 above were in conformance with the rules of the Michigan Board of Land Surveyors or by a Decree of a Court of Law, established, re-established, monumented, re-monumented, recovered, found as expressed below.

NOTE: Not more than 4 corners, all in the same town and range, may be recorded on this certificate.

	A	B	C	D	E	F	G	H	I	J	K	L
2	6	5	4	3	2	1						
3												
4	7	8	9	10	11	12						
5												
6	18	17	16	15	14	13						
7												
8	19	20	21	22	23	24						
9												
10	30	29	28	27	26	25						
11	●											
12	31	32	33	34	35	36						
13												

A. Description of original monument and accessories and/or subsequent restorations:

01/01/1816 G.L.O. Set post
NO WITNESSES REMAIN
01/01/1930 B of T Set iron
1 N 19.36 NAIL IN W FACE FENCE POST

(Witnesses Continued on Back ...)

B. Description of corner evidence found and/or method applied in restoring or reestablishing corner:

fd. 1/2" pipe w/stones & bricks. Verified corner by dist. to W.

C. Description of monument for corner and accessories established to perpetuate locating the position of the corner:


11/30/1994 Wilkerson 21584 O.I.L.M. Remon.
SET W.C.R. WASHER AND CAP ON CORNER
5 000 AZ 32.35 OHM TAG W FACE PP
6 070 AZ 62.95 OHM TAG W FACE 12" OAK
7 131 AZ 45.81 TOP NUT ON HYD.
8 240 AZ 40.00 OHM TAG N FACE 12" OAK

\$ 16.00 MISCELLANEOUS RECORDING
28 DEC 94 1:36 P.M. RECEIPT# 51B
RECORDED
FOREST E. YOUNGBLOOD, REGISTER OF DEEDS
WAYNE COUNTY, MI

We conclude that after careful study of the record documentation and field observations, that this corner is accepted as the best available evidence of the position of the original corner.

Signed by [Signature]
Drafted by Kenneth S. Wilkerson
Surveyor's Michigan License No. 21584
Orchard, Hiltz and McCliment, Inc. 34935 Schoolcraft Road Livonia, MI 48150

Date Dec 27 1994

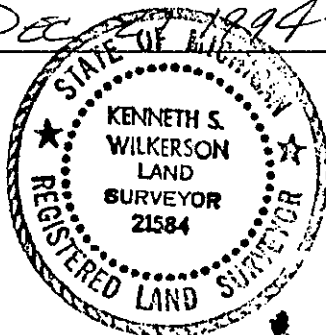

2R
140
MISC.

A. (Continued) Description of original monument and accessories and/or subsequent restorations:

01/01/1930

B of T Set iron

- 2 NE 68.00 NAIL IN SE FACE 14" OAK
- 3 SE 98.20 NAIL IN N FACE 36" OAK
- 4 SW 98.05 NAIL IN N FACE 36" OAK

09/09/1990

W.C.R.C. Fd. stone

- 1 N 19.36 NAIL IN W FACE FENCE POST
- 2 NE 68.00 NAIL IN SE FACE 14" OAK
- 3 SE 98.20 NAIL IN N FACE 36" OAK
- 4 SW 98.05 NAIL IN N FACE 36" OAK