

**SURVEY &  
REMONUMENTATION**

**RC 1434**

**L127794PA294**

**APR 25 1995**

**LAND CORNER RECORDATION CERTIFICATE**  
Filing Requirement of Act 74, Mich. P.A. 1970

E-13 Page 1

**COMMISSION**  
For corners in

Wayne County	Located In:	Sumpler	Corner Code
1. Public Land Survey	T 4 S R 8 E		E-13
	T _____ R _____		_____
	T _____ R _____		_____
	T _____ R _____		_____
2. Property Controlling In Section	S _____ T _____ R _____		_____
	S _____ T _____ R _____		_____
3. Miscellaneous Property in Sec.	S _____ T _____ R _____		_____
	S _____ T _____ R _____		_____
4. Lot No. _____, Recorded Plat _____			
5. Private Claims _____			

Compliance with  
ACT 345, P.A. 1990

APPROVED ON: 12/9/94 W.C.D.  
WAYNE COUNTY REMONUMENTATION  
PEER GROUP COMMITTEE

Register of Deeds Stamp and File Number

	A	B	C	D	E	F	G	H	I	J	K	L	M
2	6	5	4	3	2	1							
3													
4	7	8	9	10	11	12							
5													
6	18	17	16	15	14	13							
7													
8	19	20	21	22	23	24							
9													
10	30	29	28	27	26	25							
11													
12	31	32	33	34	35	36							
13													

I, Kenneth S. Wilkerson in a field survey on 07/10/1994  
do hereby certify that under requirements of P.A. 74, Michigan P.A. of 1970, the corner points mentioned in lines 1 and 2 above were in conformance with regulations and rules therefore as required in the current manual of survey instructions of the United States Department of the Interior, Bureau of Land Management, or by a decree of a Court of Law and/or that the corner points mentioned in lines 3, 4 and 5 above were in conformance with the rules of the Michigan Board of Land Surveyors or by a Decree of a Court of Law, established, re-established, monumented, re-monumented, recovered, found as expressed below.

NOTE: Not more than 4 corners, all in the same town and range, may be recorded on this certificate.

A. Description of original monument and accessories and/or subsequent restorations:

01/01/1816 Wampler G.L.O. Set post  
20" W. OAK S 6 W 60 LINKS (39.60') (GONE)  
24" W. OAK N 2 W 9 LINKS (5.94') (GONE)

( Witnesses Continued on Back ...)

B. Description of corner evidence found and/or method applied in restoring or reestablishing corner:

Fd. 3/8" re-rod in chipped hole in asph. pvm't. @ int. of cl's of Elwell & Oakville-Waltz Rds. Dist to F-13 = 2655.57 (R), 2655.73' (M)

C. Description of monument for corner and accessories established to perpetuate locating the position of the corner:


07/10/1994 wilkerson 21584 O.H.M. Remon.  
SET W.C.R. WASHER & CAP ON CORNER ALSO SET MON. BOX  
5 W.C.R. TAG IN N.E. SIDE 52" OAK N 70 W 86.72'  
8 W.C.R. TAG W/S P.P. N 35 E 68.27'  
10 W.C.R. TAG W/P.K. NAIL IN N.W. SIDE 24" ASH S 60 W 65.43'  
11 CROSS IN W.C.R.C. B.M.#21-224, BRNZ. DISK, N 50 E 44.54'  
12 W.C.R. TAG W/P.K. NAIL IN N.E./S P.P. S 30 E 38.72'

\$ 16.00 MISCELLANEOUS RECORDING  
21 DEC 94 3:19 P.M. RECEIPT# 93A  
RECORDED  
FOREST E. YOUNGBLOOD, REGISTER OF DEEDS  
WAYNE COUNTY, MI

We conclude that after careful study of the record documentation and field observations, that this corner is accepted as the best available evidence of the position of the original corner.

Signed by [Signature]  
Drafted by Kenneth S. Wilkerson  
Surveyor's Michigan License No. 21584

Date

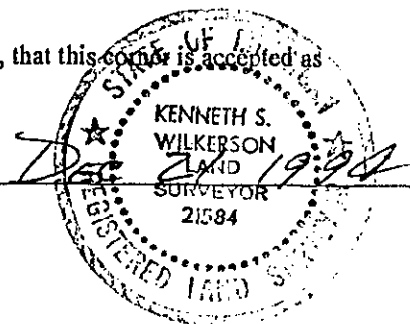

Orchard, Hiltz and McCliment, Inc. 34935 Schoolcraft Road Livonia, MI 48150

Z R  
14 N - Misc.

^ (Continued) Description of original monument and accessories and/or subsequent restorations:

01/01/1930

Wayne Co.  
Bureau of  
Taxation

Cross LI27794PA295

- 1 CROSS ON CULVERT N.E. 25.06' (GONE)
- 2 CROSS ON CULVERT N.W. 25.91' (GONE)
- 3 4" OAK S.W. 65.58'(GONE)
- 4 MONUMENT WEST 400.52'
- 5 30" OAK N.W. 87.18'
- 6 W.C.R. SIGN N.W. 43.15' (GONE)
- 13 DIST = 2655.37' TO D-13
- 14 DIST = 400.91' TO E-1, T.5S., R.8E.

01/01/1970

Wayne Co.  
Road Comm.

Fd. iron

- 7 CROSS CUT W.C.R.C. SIGN N.W. 40.26'
- 8 ED. POLE N.E. 68.20'
- 9 ED. POLE S.E. 37.55'
- 10 18" ASH S.W. 65.47'

09/22/1975

McMahon

4018

Certificate Fd. p.k. nail

NO WITNESSES

06/21/1977

Ayers

4615

Certificate

NO WITNESSES