

FEB 28 1994

COMMISSION

RC 1322

LAND CORNER RECORDATION CERTIFICATE
Filing Requirement of Act 74, Mich. P.A. 1970

LI 27042 PA 344

For corners in

Wayne
County:
SUMPTER TOWNSHIP

Located in: Corner Code #

1. Public Land Survey T 4 S R 8 E C-03
T R
T R
T R

2. Property Controlling in Section S T
S T R

3. Miscellaneous Property in Sec. S T R
S T R

4. Lot No. _____ Recorded Plat _____

5. Private Claims _____

Compliance with
ACT 345, P.A. 1990

APPROVED ON: 12-15-93 [Signature]
WAYNE COUNTY REMONUMENTATION
PEER GROUP COMMITTEE

Register of Deeds Stamp & File Number

RC 1322

I, Kenneth S. Wilkerson, in a field survey on October 09, 19 93, do hereby certify that under requirements of P.A. 74, Michigan P.A. of 1970, the corner points mentioned in lines 1 and 2 above were in conformance with regulations and rules therefore as required in the current manual of survey instructions of the United States Department of the Interior, Bureau of Land Management or by a decree of a Court of Law and/or that the corner points mentioned in lines 3, 4 and 5 above were in conformance with the rules of the Michigan Board of Land Surveyors or by a Decree of a Court of Law; established, re-established, monumented, re-monumented, recovered, found as expressed below:

NOTE: Not more than 4 corners, all in the same town and range, may be recorded on this certificate.

A. Description of original monument and accessories and/or subsequent restoration:

C-03 Set Post - GLO - NO GLO WITNESSES REMAIN
Fd. Iron - B of T
Mon. - WCRC (9/09/70)
Mon. - L. 18340, P. 688 (12/01/72)

N 50 E nail & cap W end guard rail
S 10 E 47.40 5" steel post
S 30 E 81.80 nut on hyd
N 50 W 43.90 nail & cap N face MBT P

B. Description of corner evidence found and/or method applied in restoring or reestablishing corner:

C-03 Fd 1/2" iron in mon box

Verified by measurements to west
2,699.75 R
2,699.61 M
2,699.84 R

to south 2,677.01 R
2,677.65 M
2,677.06 R

C. Description of monument for corner and accessories established to perpetuate locating the position of the corner:



Set Wayne County remonumentation washer and OHM - KSW 21584 cap on iron.

C-03 S 45 E 68.10 OHM tag in NE face 18" apple
S 81 W 87.23 OHM tag in NW face twin 19" evergreen
N 74 W 95.73 OHM tag in SW face MBT P
N 55 W 44.67 OHM tag in SW face MBT P

The selected location is accepted as the best evidence of the position of the original corner.

Signed by: [Signature]
Drafted By: Kenneth S. Wilkerson
Surveyor's Michigan License No. 21584

Date: Nov 30 1993

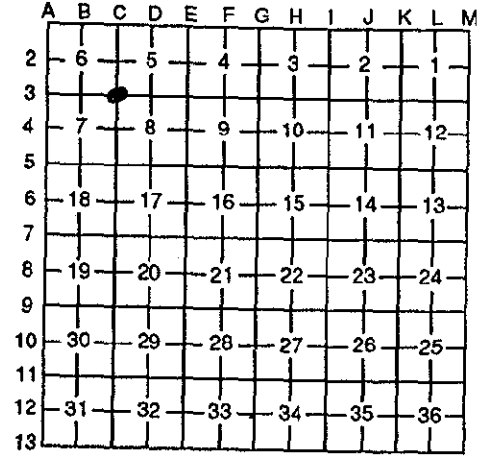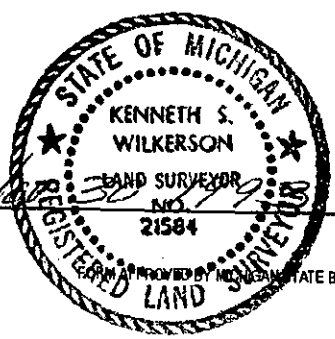

93 DEC 15 PM 4:59
FOREST E. YOUNG BLOOD
REGISTERED REGISTERED DEEDS.
MICHIGAN REGISTERED DEEDS.

2R
11K11