

**SURVEY &  
REMONUMENTATION**

**RC 1624**

**LAND CORNER RECORDATION CERTIFICATE**

**LI27802PA191**

**APR 25 1995**

Filing Requirement of Act 74, Mich. P.A. 1970

C-12 Page 1

For corners in **COMMISSION**

Wayne	Located in:	Sumpter	Corner Code
County			
<b>SUMPTER</b>			
1. Public Land Survey	T <u>4</u> S R <u>8</u> E		C-12
	T _____ R _____		_____
	T _____ R _____		_____
	T _____ R _____		_____
2. Property Controlling In Section	S _____ T _____ R _____		_____
	S _____ T _____ R _____		_____
3. Miscellaneous Property in Sec.	S _____ T _____ R _____		_____
	S _____ T _____ R _____		_____
4. Lot No. _____, Recorded Plat _____			
5. Private Claims _____			

Compliance with  
ACT 345, P.A. 1990  
APPROVED ON: 12-9-94 *DPJ*  
WAYNE COUNTY REMONUMENTATION  
PEER GROUP COMMITTEE

Register of Deeds Stamp and File Number

	A	B	C	D	E	F	G	H	I	J	K	L
2	6	5	4	3	2	1						
3												
4	7	8	9	10	11	12						
5												
6	18	17	16	15	14	13						
7												
8	19	20	21	22	23	24						
9												
10	30	29	28	27	26	25						
11												
12	31	32	33	34	35	36						

I, Kenneth S. Wilkerson in a field survey on 11/30/1994  
do hereby certify that under requirements of P.A. 74, Michigan P.A. of 1970, the corner points mentioned in lines 1 and 2 above were in conformance with regulations and rules therefore as required in the current manual of survey instructions of the United States Department of the Interior, Bureau of Land Management, or by a decree of a Court of Law and/or that the corner points mentioned in lines 3, 4 and 5 above were in conformance with the rules of the Michigan Board of Land Surveyors or by a Decree of a Court of Law, established, re-established, monumented, re-monumented, recovered, found as expressed below.

NOTE: Not more than 4 corners, all in the same town and range, may be recorded on this certificate.

A. Description of original monument and accessories and/or subsequent restorations:

01/01/1930

B. of T. Set iron

- 1 FENCE N & S AND E & W
- 2 SE 48.25 NAIL IN N FACE 30" OAK

(Witnesses Continued on Back ...)

B. Description of corner evidence found and/or method applied in restoring or reestablishing corner:

Fd. 3/4" pipe 1" below grade. Verified witnesses.

C. Description of monument for corner and accessories established to perpetuate locating the position of the corner:

11/30/1994 Wilkerson 21584 O.H.M. Remon.

SET W.C.R. WASHER AND CAP ON CORNER


- 1 Fd. N & S AND E & W FENCE
- 4 10.46 MEAS 10.5 TO 10" OAK
- 5 15.98 MEAS 16.0 TO 26" OAK
- 6 100 AZ 41.24 OHM TAG IN E FACE 14" OAK
- 7 100 AZ 9.93 OHM TAG IN N FACE 10" ELM
- 8 221 AZ 10.39 OHM TAG IN E FACE 10" W OAK
- 9 261 AZ 15.50 OHM TAG IN N FACE 26" W OAK

\$ 16.00 MISCELLANEOUS RECORDING  
28 DEC 94 1:37 P.M. RECEIPT# 518  
RECORDED  
FOREST E. YOUNGBLOOD, REGISTER OF DEEDS  
WAYNE COUNTY, MI

We conclude that after careful study of the record documentation and field observations, that this corner is accepted as the best available evidence of the position of the original corner.

Signed by *Kenneth S. Wilkerson*  
Drafted by Kenneth S. Wilkerson  
Surveyor's Michigan License No. 21584

Date

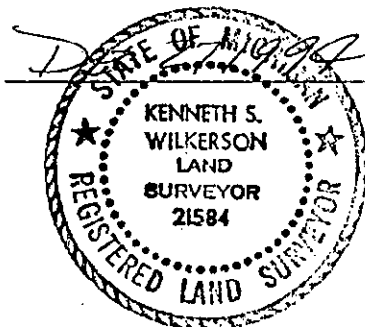

Orchard, Hiltz and McCliment, Inc. 34935 Schoolcraft Road Livonia, MI 48150

2R  
14 D  
MISC.

## A. (Continued) Description of original monument and accessories and/or subsequent restorations:

01/01/1816

NO WITNESSES REMAIN

G.L.O. Set post

01/01/1930

- 3 S 41.50 NAIL IN W FACE 14" OAK
- 4 SW 10.46 NAIL IN SE FACE 10" OAK
- 5 W 15.98 NAIL IN S FACE 26" OAK

B. of T. Set iron

N