

**SURVEY &
REMONUMENTATION**

RC 1433

LI27794PA292

APR 25 1995

LAND CORNER RECORDATION CERTIFICATE
Filing Requirement of Act 74, Mich. P.A. 1970

C-13 Page 1

COMMISSION

For corners in

Wayne
County

Located In: Sumpler Corner Code

- | | | | |
|---------------------------------------|---------|---------------------------|-------------|
| 1. Public Land Survey | | T <u>4</u> S R <u>8</u> E | <u>C-13</u> |
| | | T _____ R _____ | _____ |
| | | T _____ R _____ | _____ |
| | | T _____ R _____ | _____ |
| 2. Property Controlling In Section | S _____ | T _____ R _____ | _____ |
| | S _____ | T _____ R _____ | _____ |
| 3. Miscellaneous Property in Sec. | S _____ | T _____ R _____ | _____ |
| | S _____ | T _____ R _____ | _____ |
| 4. Lot No. _____, Recorded Plat _____ | | | |
| 5. Private Claims _____ | | | |

Compliance with
ACT 345, P.A. 1990
APPROVED ON: 12/9/94 WCO
WAYNE COUNTY REMONUMENTATION
PEER GROUP COMMITTEE

Register of Deeds Stamp and File Number

	A	B	C	D	E	F	G	H	I	J	K	L	M
2	8	5	4	3	2	1							
3													
4	7	8	9	10	11	12							
5													
6	18	17	16	15	14	13							
7													
8	19	20	21	22	23	24							
9													
10	30	29	28	27	26	25							
11													
12	31	32	33	34	35	36							
13													

I, Kenneth S. Wilkerson in a field survey on 12/2/1994
do hereby certify that under requirements of P.A. 74, Michigan P.A. of 1970, the corner points mentioned in lines 1 and 2 above were in conformance with regulations and rules therefore as required in the current manual of survey instructions of the United States Department of the Interior, Bureau of Land Management, or by a decree of a Court of Law and/or that the corner points mentioned in lines 3, 4 and 5 above were in conformance with the rules of the Michigan Board of Land Surveyors or by a Decree of a Court of Law, established, re-established, monumented, re-monumented, recovered, found as expressed below.

NOTE: Not more than 4 corners, all in the same town and range, may be recorded on this certificate.

A. Description of original monument and accessories and/or subsequent restorations:
01/01/1816 Wampler G.L.O. Set post
15" ELM S 32 E 50 LINKS (33.0') (GONE)
12" ASH N 40 E 9 LINKS (5.94') (GONE)

(Witnesses Continued on Back ...)

B. Description of corner evidence found and/or method applied in restoring or reestablishing corner:
Set 1/2" i.r. using Wayne Co. witnesses and capped iron N 43.00' & set mon. box.. Dist. to B-13 = 2637.22 (R), 2637.32'(M) & Dist to D-13 = 2653.17(R), 2653.27(M)

C. Description of monument for corner and accessories established to perpetuate locating the position of the corner:
12/12/1994 Wilkerson 21584 O.I.L.M. Remon.
SET W.C.R. WASHER & CAP ON CORNER
8 TOP OF HYD. N35W 47.76'
9 PROP. CORNER TO NORTH 43.00'
10 SET W.C.R. TAG ON P.P. N20E 48.87'
11 SET W.C.R. TAG P.P. S50E 57.55'


\$ 16.00 MISCELLANEOUS RECORDING
21 DEC 94 3:18 P.M. RECEIPT# 93A
RECORDED
FOREST E. YOUNGBLOOD, REGISTER OF DEE
WAYNE COUNTY, MI

We conclude that after careful study of the record documentation and field observations, that this corner is accepted as the best available evidence of the position of the original corner.

Signed by [Signature]
Drafted by Kenneth S. Wilkerson
Surveyor's Michigan License No. 21584

Date Dec 21 1994

Orchard, Hiltz and McCliment, Inc. 34935 Schoolcraft Road Livonia, MI 48150

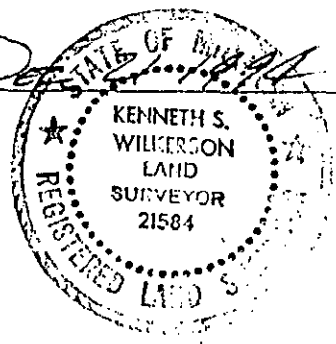

Z R
14 13 14.00

A. (Continued) Description of original monument and accessories and/or subsequent restorations:

01/01/1930

Wayne Co.
Bureau of
Taxation

Set iron

- 1 15" OAK N.E. 63.05' (GONE)
- 2 18" ELM N.E. 38.00' (GONE)
- 3 GUARD POST N.W. 71.93' (GONE)
- 4 DIST = 2637.22' TO B-13
- 5 DIST = 2653.17' TO D-13

01/01/1970

Wayne Co.
Road Comm.

Not specified

- 3 GUARD POST N.W. 71.93'
- 6 BELL POLE NORTHERLY 51.40'
- 7 BELL POLE SOUTHEASTERLY 56.90'

04/07/1992

Blanchard

27446

Kubisky &
Associates

Certificate

NO WITNESSES