

FEB 29 1994

RC 1326

LAND CORNER RECORDATION CERTIFICATE
Filing Requirement of Act 74, Mich. P.A. 1970

LI27042PA348

COMMISSION

For corners in

Wayne			
County:			
SUMPTER TOWNSHIP		Located in:	Corner Code #
1. Public Land Survey		T 4 S R 8 E	E-09
		T _____ R _____	_____
		T _____ R _____	_____
		T _____ R _____	_____
2. Property Controlling in Section	S _____	T _____ R _____	_____
	S _____	T _____ R _____	_____
3. Miscellaneous Property in Sec.	S _____	T _____ R _____	_____
	S _____	T _____ R _____	_____

Compliance with
ACT 345, P.A. 1990

APPROVED ON: 12-15-93 *PKL*

WAYNE COUNTY REMONUMENTATION
PEER GROUP COMMITTEE

Register of Deeds Stamp & File Number

RC 1326

4. Lot No. _____, Recorded Plat _____

5. Private Claims _____

I, Kenneth S. Wilkerson in a field survey on October 09, 19 93, do hereby certify that under requirements of P.A. 74, Michigan P.A. of 1970, the corner points mentioned in lines 1 and 2 above were in conformance with regulations and rules therefore as required in the current manual of survey instructions of the United States Department of the Interior, Bureau of Land Management or by a decree of a Court of Law and/or that the corner points mentioned in lines 3, 4 and 5 above were in conformance with the rules of the Michigan Board of Land Surveyors or by a Decree of a Court of Law; established, re-established, monumented, re-monumented, recovered, found as expressed below:

NOTE: Not more than 4 corners, all in the same town and range, may be recorded on this certificate.

A. Description of original monument and accessories and/or subsequent restoration:

- E-09 Sat Post - GLO - NO GLO WITNESSES REMAIN
Fd. Iron - B of T
Fd. Mon. - L. 18772, P. 517, (2/13/74)
- N 20 E nail SE face 28" walnut
- N 40 E WCRC sign
- S 50 E 60.75 cor fence post
- S 45 W 46.95 nail SE face MBT P
- N 60 W 61.15 nail SW face MBT P

B. Description of corner evidence found and/or method applied in restoring or reestablishing corner:

- E-09 Fd 1/2" rod in mon box
- Verified by observation and witness per L. 19024, P. 276


C. Description of monument for corner and accessories established to perpetuate locating the position of the corner:

- Set Wayne County remonumentation washer and OHM - KSW 21584 cap on iron.
- E-09 025 az 82.70 OHM tag W face 28" walnut
- 119 az 67.60 OHM tag in N face Lt P
- 228 az 46.25 OHM tag in N face Guy P
- 336 az 70.15 OHM tag in E face PP

The selected location is accepted as the best evidence of the position of the original corner.

Signed by: *[Signature]*

Date: Nov 15 1993

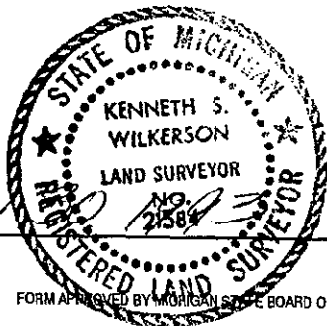

Drafted By: Kenneth S. Wilkerson
Surveyor's Michigan License No. 21584

Orchard, Hiltz & McCliment, Inc.
34935 Schoolcraft Road * Livonia, Michigan 48150 * Phone: (313) 522-6711

FORM APPROVED BY MICHIGAN STATE BOARD OF LAND SURVEYORS, JAN. 28, 1971
REVISED MAY 14, 1975
REVISED JAN., 1983

93 DEC 15 PM 4:59

2R
11KD