

LAND CORNER RECORDATION CERTIFICATE

APR 05 1996 Filing Requirement of Act 74, Mich. P.A. 1970

F-05 Page 1

For corners in Wayne County

COMMISSION

Located in: Sumpter Corner Code

- 1. Public Land Survey T 4 S R 8 E F-05
2. Property Controlling in Section S T R
3. Miscellaneous Property in Sec. S T R
4. Lot No. Recorded Plat
5. Private Claims

Compliance with ACT 345, P.A. 1990

APPROVED ON: 11-30-95 DBL WAYNE COUNTY REMONUMENTATION PEER GROUP COMMITTEE

Register of Deeds Stamp and File Number

Grid table with columns A-L and rows 2-13. A dot is marked at the intersection of column G and row 5.

I, Kenneth S. Wilkerson in a field survey on 06/30/1995 do hereby certify that under requirements of P.A. 74, Michigan P.A. of 1970, the corner points mentioned in lines 1 and 2 above were in conformance with regulations and rules therefore as required in the current manual of survey instructions of the United States Department of the Interior, Bureau of Land Management...

NOTE: Not more than 4 corners, all in the same town and range, may be recorded on this certificate.

A. Description of original monument and accessories and/or subsequent restorations: 01/01/1816 Wampler G.L.O. Set post 20" B. OAK S 3 E 25 LINKS (16.5') (GONE) 18" W. OAK N 5 W 40 LINKS (26.4') (GONE)

(Witnesses Continued on Back ...)

B. Description of corner evidence found and/or method applied in restoring or reestablishing corner: Fd. Mon. w/ 1" pipe in gravel road @ 4'S. of int. of cl's of Judd & Bohn Rds. dist to E-05 2638.66' (R) 2638.66(M) WPA DIST TO G-05 2200.36'(R) 2200.24(M) WPA

C. Description of monument for corner and accessories established to perpetuate locating the position of the corner: 06/30/1995 Wilkerson 35994 O.H.M. Remon. SET W.C.R. WASHER & CAP OVER CORNER. 3 W.C.R. TAG W/ PK NAIL IN W. SIDE 38" OAK S 30 W 56.91' 4 W.C.R. TAG IN N.E. SIDE 30" OAK N 45 W 64.15' 6 TOP BOLT ON HYDRANT S 53 E 57.74 9 RESET W.C.R. TAG W/PK. NAIL IN N.E./S.P.P. N 50 W 54.25 11 W.C.R. TAG E. SIDE 36" OAK N 10 W 29.07' 12 W.C.R. TAG S.E./S LT. POLE N 48 E 57.89'


\$ 10.00 DEED 21 DEC 95 9:17 A.M. RECEIPT# 58 RECORDED FOREST E. YOUNGBLOOD, REGISTER OF DEEDS WAYNE COUNTY, MI \$ 4.00 REMONUMENTATION

95273110

We conclude that after careful study of the record documentation and field observations, that this corner is accepted as the best available evidence of the position of the original corner.

Signed by [Signature] Drafted by Kenneth S. Wilkerson Surveyor's Michigan License No. 21584 Orchard, Hiltz and McCliment, Inc. 34935 Schoolcraft Road Livonia, MI 48150

Date DEC 25 1995

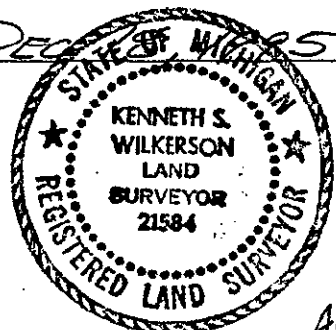

AR 10.15

A. (Continued) Description of original monument and accessories and/or subsequent restorations:

LIBER 28477 PAGE 189
 Fd. Stone

01/01/1930			Wayne Co. Bureau of Taxation		
	1	18" CHERRY N.E. 69.14' (GONE)			
	2	W.C.R. SIGN POST S.E. 31.70' (GONE)			
	3	16" OAK S. W. 57.10'			
	4	8" OAK N.W. 64.33'			
	5	18" MAPLE NORTH 31.5'			
	13	DIST = 2638.66' TO E-05			
	14	DIST = 2200.24' TO G-05			
06/22/1970		D. Ferrier	Wayne Co. Road Comm.		Mon.
	3	31" OAK S.W. 57.05'			
	5	36" MAPLE NORTH 31.68'			
	6	TOP OF HYD. S.E. 57.74'			
	7	W.C.R.C. SIGN S.E. 56.60' (GONE)			
	8	D.E. POLE N.W. 49.79' (GONE)			
06/13/1973		Jagow	6998 Atwell-Hicks	Certificate	Fd. 1/2" I pipe in mon. box
	3	30" OAK S 25 W 57.0'			
	4	24" OAK NORTHWESTERLY 64.4'			
	5	36" MAPLE NORTH 31.5'			
	10	ROAD SIGN S 45 E 39.2' (GONE)			
06/27/1973		Nowak	13300 Nowak & Fraus	6 Certificates of Survey	
		NO WITNESSES			
07/06/1973		Nowak	13300 Nowak & Fraus	L.184	Fd. 1/2" iron pipe
	3	P.K. NAIL IN 36" TREE S 30 W 57.10'			
	5	P.K. NAIL IN 36" TREE NORTH 31.70'			
	9	P.K. NAIL IN POWER POLE N 50 W 54.20'			
12/01/1977		Jarrett	12700 Brender-Hamill	Certificate	
		NO WITNESSES			
12/06/1977		Jarrett	12700	1.2004	Mon.
	3	NAIL IN W. SIDE 36" OAK S 27 W 57.10'			
	5	P. K. NAIL E. SIDE 40" OAK NORTH 31.68'			
	6	TOP BOLT HYD. S 53 E 57.55'			
	9	P. K. NAIL IN N.E. SIDE M.B.T. POLE N 50 W 54.21'			
06/15/1989		Timmons	23319 Atwell-Hicks	Certificate	Monument
	3	36" OAK S 30 W 55.95'			
	4	24" OAK N 45 W 64.10'			
	5	36" OAK NORTH 31.65'			
	11	36 OAK N 10 W 29.00'			

FILED DO NOT MAIL