

RC 1327

LAND CORNER RECORDATION CERTIFICATE  
Filing Requirement of Act 74, Mich. P.A. 1970

L127042 PA349

FEB 29 1994

For corners in

Wayne  
County: SUMPTER TOWNSHIP

Located in: Corner Code #

1. Public Land Survey T 4 S R 8 E G-03  
T R  
T R  
T R

2. Property Controlling in Section S S T T R R  
S S T T R R

3. Miscellaneous Property in Sec. S S T T R R  
S S T T R R

4. Lot No. \_\_\_\_\_, Recorded Plat \_\_\_\_\_

5. Private Claims \_\_\_\_\_

Compliance with  
ACT 345, P.A. 1990

APPROVED ON: 12-15-93 [Signature]

WAYNE COUNTY REMONUMENTATION  
PEER GROUP COMMITTEE

Register of Deeds Stamp & File Number

RC 1327

I, Kenneth S. Wilkerson, in a field survey on October 04, 19 93  
do hereby certify that under requirements of P.A. 74, Michigan P.A. of 1970, the corner points mentioned  
in lines 1 and 2 above were in conformance with regulations and rules therefore as required in the current  
manual of survey instructions of the United States Department of the Interior, Bureau of Land Management  
or by a decree of a Court of Law and/or that the corner points mentioned in lines 3, 4 and 5 above were in  
conformance with the rules of the Michigan Board of Land Surveyors or by a Decree of a Court of Law;  
established, re-established, monumented, re-monumented, recovered, found as expressed below:

NOTE: Not more than 4 corners, all in the same town and range, may be recorded on this certificate.

A. Description of original monument and accessories and/or subsequent restoration:

G-03 Set Post - GLO - NO GLO WITNESSES REMAIN  
Fd. Iron - B of T  
Fd. Iron - WCRC - 4/13/72  
Fd 1" pipe in man box - L. 18340, P. 690 - 12/01/72

N 60 E 70.45 SE cor steps at bar  
S 40 E PK in W face PP  
S 40 W 80.87 edge of door opening in bldg  
N 60 E 70.45 SE cor steps at bar

B. Description of corner evidence found and/or method applied in restoring or reestablishing corner:

G-03 Fd 5/8" pipe in man box per L. 18340, P. 690

C. Description of monument for corner and accessories established to perpetuate locating the position of the corner:

Set Wayne County remonumentation washer and OHM - KSW 21584 cap on iron.

G-03 107 az 112.21 top nut on hyd  
149 az 61.93 OHM tag SW face PP  
214 az 78.99 NE cor Walt Oil Co  
285 az 89.44 OHM tag NE face PP

The selected location is accepted as the best evidence of the position of the original corner.

	A	B	C	D	E	F	G	H	I	J	K	L	M
2	6	5	4	3	2	1							
3													
4	7	8	9	10	11	12							
5													
6	18	17	16	15	14	13							
7													
8	19	20	21	22	23	24							
9													
10	30	29	28	27	26	25							
11													
12	31	32	33	34	35	36							
13													


Signed by:

[Signature]

Drafted By: Kenneth S. Wilkerson  
Surveyor's Michigan License No. 21584

Orchard, Hiltz & McCliment, Inc.  
34935 Schoolcraft Road \* Livonia, Michigan 48150 \* Phone: (313) 522-6711

Date:

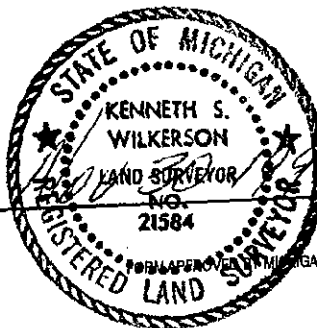

APPROVED BY: [Signature]  
MICHIGAN STATE BOARD OF LAND SURVEYORS, JAN. 26, 1971  
REVISED MAY 14, 1976  
REVISED JAN., 1983

9: DEC 15 PM 4: 59  
FOREST E. YOUNGBLOOD  
REGISTERED DEEDS  
MICHIGAN COUNTY, MI

22  
11KD