

**SURVEY & REMONUMENTATION LAND CORNER RECORDATION CERTIFICATE**

LIBER 28477 PAGE 186

Filing Requirement of Act 74; Mich. P.A. 1970

APR 05 1996

G-06 Page 1

For corners in  
Wayne **COMMISSION** Located in: Sumpter Corner Code  
County

1. Public Land Survey	T	4	S	R	8	E	G-06
	T			R			
	T			R			
	T			R			
2. Property Controlling in Section	S		T	R			
	S		T	R			
3. Miscellaneous Property in Sec.	S		T	R			
	S		T	R			
4. Lot No. _____, Recorded Plat _____							
5. Private Claims _____							

Compliance with  
ACT 345, P.A. 1990

APPROVED ON: 11-30-95  
WAYNE COUNTY REMONUMENTATION  
PEER GROUP COMMITTEE

Register of Deeds Stamp and File Number

I, Kenneth S. Wilkerson in a field survey on 06/20/1995 do hereby certify that under requirements of P.A. 74, Michigan P.A. of 1970, the corner points mentioned in lines 1 and 2 above were in conformance with regulations and rules therefore as required in the current manual of survey instructions of the United States Department of the Interior, Bureau of Land Management, or by a decree of a Court of Law and/or that the corner points mentioned in lines 3, 4 and 5 above were in conformance with the rules of the Michigan Board of Land Surveyors or by a Decree of a Court of Law, established, re-established, monumented, re-monumented, recovered, found as expressed below.

**NOTE: Not more than 4 corners, all in the same town and range, may be recorded on this certificate.**

	A	B	C	D	E	F	G	H	I	J	K	L	M
2	6	5	4	3	2	1							
3													
4	7	8	9	10	11	12							
5													
6	18	17	16	15	14	13							
7													
8	19	20	21	22	23	24							
9													
10	30	29	28	27	26	25							
11													
12	31	32	33	34	35	36							
13													

A. Description of original monument and accessories and/or subsequent restorations:

01/01/1819 Wampler G.L.O. Set post  
7" R. OAK S 59 E 5 LINKS (3.30') (GONE)  
6" DOGWOOD N 53 W 10 LINKS (6.66') (GONE)

(Witnesses Continued on Back ...)

B. Description of corner evidence found and/or method applied in restoring or reestablishing corner:

Fd. 1/2" iron in mon. box (no lid) @ int. of cl's of Sumpter & Clay Rds. Dist. to G-5 = 2634.47 (R) 2634.12' (M) & Dist. to G-7 = 2647.99 (R) 2648.33' (M)

C. Description of monument for corner and accessories established to perpetuate locating the position of the corner:

06/20/1995 Wilkerson 35994 O.H.M. Remon.

- SET W.C.R. WASHER & TAG ON FD MON. REPLACED LID.
- 4 W.C.R. TAG S.E. SIDE 24" OAK S 39 W 54.35'
- 7 W.C.R. TAG N/S P.P. WEST 32.06'
- 8 W.C.R. TAG N.W. SIDE 24" OAK N 40 E 53.65'
- 12 W.C.R. TAG N.W./S P.P. S 24 E 48.23'


\$ 10.00 DEED  
21 DEC 95 9:17 A.M. RECEIPT# 58  
RECORDED  
FOREST E. YOUNGBLOOD, REGISTER OF DEEDS  
WAYNE COUNTY, MI  
\$ 4.00 REMONUMENTATION

We conclude that after careful study of the record documentation and field observations, that this corner is accepted as the best available evidence of the position of the original corner.

Signed by [Signature]  
Drafted by Kenneth S. Wilkerson  
Surveyor's Michigan License No. 21584

Date DEC 21 1995

Orchard, Hiltz and McCliment, Inc. 34935 Schoolcraft Road Livonia, MI 48150

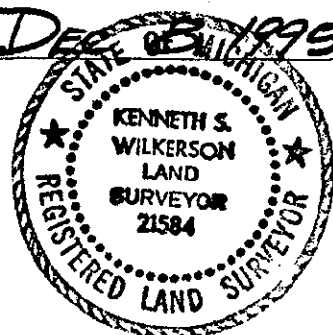

95273109

40  
100  
KS

A. (Continued) Description of original monument and accessories and/or subsequent restoration

LIBER 28477  
Fd. cross

PAGE 187

01/01/1930

Wayne Co.  
Bureau of  
Taxation

- 1 ED. POLE N.E. 42.72' (GONE)
- 2 W.C.R. SIGN POST S.E. 39.64' (GONE)
- 3 14" OAK S.W. 94.55' (GONE)
- 4 5" OAK S.W. 54.70'
- 5 12" TWIN-ELM N.W. 22.17' (GONE)
- 6 12" ELM 60.00' (GONE)
- 13 DIST = 2647.99' (R) TO G-07 2648.33' (M 1995)
- 14 DIST = 2634.47' (R) TO G-05 2634.12' (M 1995)
- 15 BS G-5 FS G-7 ANGLE TO R = 181-53-25 (M), 181-53-17 (M)

04/13/1972

Klopshinske

W.C.R.C.

- 4 14" OAK S.W. 54.70'
- 7 M.B.T. POLE WESTERLY 31.95'
- 8 14" OAK N.E. 53.49'
- 9 15" OAK S.E. 81.07' (GONE)

02/18/1977

Trim

13913

Wade, Trim

Certified

Iron in pot

- 4 NAIL IN SE SIDE 16" OAK S.W. 54.63'
- 7 NAIL IN N SIDE M.B.T. POLE S 88 W 31.75'
- 8 NAIL IN NW SIDE 15" OAK N.E. 53.48'
- 10 W.C.R.C. SIGN S 46 E 39.70 (GONE)

FILED DO NOT MAIL