

LAND CORNER RECORDATION CERTIFICATE

APR 05 1996 Filing Requirement of Act 74, Mich. P.A. 1970

G-09 Page 1

For corners in Wayne County Located in: COMMISSION Sumpter Corner Code

- 1. Public Land Survey T 4 S R 8 E G-09
2. Property Controlling in Section S T R
3. Miscellaneous Property in Sec. S T R
4. Lot No. Recorded Plat
5. Private Claims

Compliance with ACT 345, P.A. 1990 APPROVED ON: 11-30-95 WAYNE COUNTY REMONUMENTATION PEER GROUP COMMITTEE

Register of Deeds Stamp and File Number

I, Kenneth S. Wilkerson in a field survey on 06/06/1995 do hereby certify that under requirements of P.A. 74, Michigan P.A. of 1970, the corner points mentioned in lines 1 and 2 above were in conformance with regulations and rules therefore as required in the current manual of survey instructions of the United States Department of the Interior, Bureau of Land Management...

Grid table with columns A-M and rows 2-13. A diamond symbol is located at the intersection of column G and row 9.

NOTE: Not more than 4 corners, all in the same town and range, may be recorded on this certificate.

A. Description of original monument and accessories and/or subsequent restorations: 01/01/1819 Wampler G.L.O. Set post 8" W. OAK S 44 E 9 LINKS (5.94') (GONE) 10" W. OAK S 63 W 33 LINKS (21.78') (GONE)

(Witnesses Continued on Back ...)

B. Description of corner evidence found and/or method applied in restoring or reestablishing corner: Fd. 1/2" rod mon. in mon. box (no lid) @ int. of cl's of Sumpter & Willow Rds. Dist. to G-8 = 2644.22 (R) 2644.45' (M) & Dist. to G-10 = 2653.58' (R) 2653.72' (M)


C. Description of monument for corner and accessories established to perpetuate locating the position of the corner: 06/06/1995 Wilkerson 35994 O.H.M. Remon. SET W.C.R. WASHER & CAP OVER FD. MON. REPLACED LID. 4 N.E. COR. BLOCK BLDG. S 54 W 74.33 12 W.C.R. TAG W./S P.P. S 44 E 59.71' 14 W.C.R. TAG S.W./S.P.P. N 38 W 51.35' 15 W.C.R. TAG S.E./S P.P. N 45 E 70.94'

\$ 10.00 DEED 21 DEC 95 9:18 A.M. RECEIPT# 58 RECORDED FOREST E. YOUNGBLOOD, REGISTER OF DEEDS WAYNE COUNTY, MI \$ 4.00 REMONUMENTATION

95273111

We conclude that after careful study of the record documentation and field observations, that this corner is accepted as the best available evidence of the position of the original corner.

Signed by [Signature] Date DEC 23 1995 Drafted by Kenneth S. Wilkerson Surveyor's Michigan License No. 21584 Orchard, Hiltz and McCliment, Inc. 34935 Schoolcraft Road Livonia, MI 48150

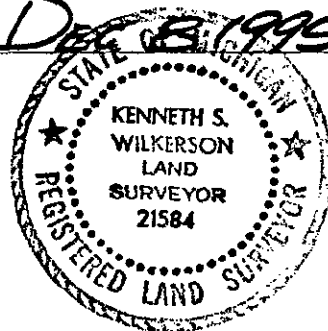

APR 10 1996

A. (Continued) Description of original monument and accessories and/or subsequent restorations:

01/01/1930			Wayne Co. Bureau of Taxation		Set iron
	1	U.S.G.S. MON. PT. 35L N.W. 54.95' (GONE)			
	2	18" OAK N.W. 79.05' (GONE)			
	3	20" CHERRY S.W. 102.35' (GONE)			
	4	NE COR. OF FRAME STORE S.W. 73.78'			
	5	ED. POLE S.E. 36.38' (GONE)			
	6	CROSS ON W.C.R. SIGN N.E. 54.38' (GONE)			
	16	DIST = 2653.58' (R) TO G-10 2653.72' (M 1995)			
	17	DIST = 2644.22' (R) TO G-08 2644.45' (M)			
	18	BS G-8 FS G-10 ANGLE TO R = 176-32-18 (R) & 176-30-30 (M 1995)			
04/13/1971		Fahrner	17620	Washtenaw Engineering	Act 132 3/4 iron pipe
	7	ED. POLE N 40 W 44.7'			
	8	5" STEEL SIGN POST S 45 W 63.5' (GONE)			
	9	3" STEEL SIGN POST N 50 E 34.4' (GONE)			
	10	P.P. S 45 E 52.9'			
09/13/1971		Fahrner	17620		R.C.1
		SAME AS ABOVE			
04/13/1972		Klopshinske		W.C.R.C.	Iron
	7	GUY POLE N.W. 44.58' (GONE)			
	10	P.P. S.E. 52.90' (GONE)			
	11	GUY POLE S.W. 159.13' (GONE)			
04/15/1974		Crossman	9428		R.C.3 Fd. mon. in handhole
	4	NE COR. BUILDING S 40 W 73.60'			
	7	W.C.R.C. CAP AND NAIL IN SW SIDE G. P. N 50 W 44.52' (GONE)			
	8	GAS STATION SIGN S 55 W 63.65' (GONE)			
	12	P.K. NAIL SW SIDE DE POLE S 40 E 59.85'			
	13	TOP BOLT OF HYD. N 25 W 68.05'			
05/03/1979		Sandomierski	24616		R.C.6 Fd. 1/2" iron in box
	4	NE COR. BLOCK BLDG. S 45 W 74.33'			
	12	P.K. NAIL NE SIDE PP S 50 E 59.97'			
	13	CENTERLINE OF HYD. N 25 W 68.90'			
	14	P.K. NAIL SW SIDE M.B.T. POLE N 45 W 51.37'			

LIBER 28477 PAGE 191

FILED DO NOT MAIL