

RC 1329

LAND CORNER RECORDATION CERTIFICATE  
Filing Requirement of Act 74, Mich. P.A. 1970

LI 27042 PA 351

FEB 23 1994

For corners in Wayne

County: SUMPTER TOWNSHIP

Located in: \_\_\_\_\_ Corner Code # \_\_\_\_\_

1. Public Land Survey	T <u>4 S</u>	R <u>8 E</u>	<u>G-11</u>
	T _____	R _____	_____
	T _____	R _____	_____
	T _____	R _____	_____
2. Property Controlling in Section	S _____	T _____	_____
	S _____	T _____	_____
3. Miscellaneous Property in Sec.	S _____	T _____	_____
	S _____	T _____	_____

4. Lot No. \_\_\_\_\_, Recorded Plat \_\_\_\_\_

5. Private Claims \_\_\_\_\_

Compliance with  
ACT 345, P.A. 1990

APPROVED ON: 12-15-93 *DJ*

WAYNE COUNTY REMONUMENTATION  
PEER GROUP COMMITTEE

Register of Deeds Stamp & File Number

RC 1329

A	B	C	D	E	F	G	H	I	J	K	L	M
2	6	5	4	3	2	1						
3												
4	7	8	9	10	11	12						
5												
6	18	17	16	15	14	13						
7												
8	19	20	21	22	23	24						
9												
10	30	29	28	27	26	25						
11												
12	31	32	33	34	35	36						
13												

I, Kenneth S. Wilkerson, in a field survey on October 04, 19 93, do hereby certify that under requirements of P.A. 74, Michigan P.A. of 1970, the corner points mentioned in lines 1 and 2 above were in conformance with regulations and rules therefore as required in the current manual of survey instructions of the United States Department of the Interior, Bureau of Land Management or by a decree of a Court of Law and/or that the corner points mentioned in lines 3, 4 and 5 above were in conformance with the rules of the Michigan Board of Land Surveyors or by a Decree of a Court of Law, established, re-established, monumented, re-monumented, recovered, found as expressed below:

NOTE: Not more than 4 corners, all in the same town and range, may be recorded on this certificate.

A. Description of original monument and accessories and/or subsequent restoration:

G-11 Set Post - GLO - NO GLO WITNESSES REMAIN  
Fd. Iron - B of T  
Mon. in Mon. Box - WCRC - 4/13/72  
Fd mon in mon box, L. 18787, P. 429 - 4/09/74

N 25 E 66.5 WCRC cap in NW face P & MBT P  
S 45 E 45.55 WCRC sign  
S 40 W 69.25 WCRC cap SE face MBT P  
N 40 W 55.00 top nut on hyd

B. Description of corner evidence found and/or method applied in restoring or reestablishing corner:

G-11 Fd 1/2" rod in mon box  
Verified by witness and observation per L. 18787, P. 429

C. Description of monument for corner and accessories established to perpetuate locating the position of the corner:

Set Wayne County remonumentation washer and OHM - KSW 21584 cap on iron.

G-11 031 az 66.47 WCRC tag NW face PP  
212 az 69.14 WCRC tag SE face PP  
285 az 81.42 OHM tag S face 18" oak  
330 az 57.88 top nut on hyd


The selected location is accepted as the best evidence of the position of the original corner.

Signed by:

Drafted By: Kenneth S. Wilkerson  
Surveyor's Michigan License No. 21584

Orchard, Hiltz & McCliment, Inc.  
34935 Schoolcraft Road \* Livonia, Michigan 48150 \* Phone: (313) 522-6711

Date:

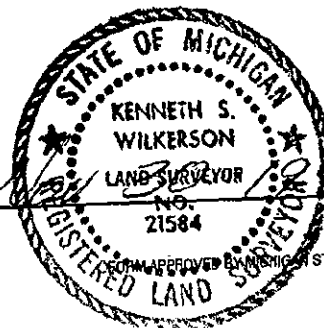

FORM APPROVED BY MICHIGAN STATE BOARD OF LAND SURVEYORS, JAN. 28, 1971  
REVISED MAY 14, 1975  
REVISED JAN., 1983

93 DEC 15 PM 4:59  
FOREST E. YOUNGBLOOD  
REGISTER OF DEEDS  
MICHIGAN DEPT. OF TREASURY

2R  
11KD