

LAND CORNER RECORDATION CERTIFICATE
APR 05 1995 Filing Requirement of Act 74, Mich. P.A. 1970

G-13 Page 1

For corners in **COMMISSION**
Wayne Located in: Sumpter Corner Code
County

- | | | | | | | | |
|------------------------------------|---|---|---|---|---|---|------|
| 1. Public Land Survey | T | 4 | S | R | 8 | E | G-13 |
| | T | | | R | | | |
| | T | | | R | | | |
| | T | | | R | | | |
| 2. Property Controlling in Section | S | | T | R | | | |
| | S | | T | R | | | |
| 3. Miscellaneous Property in Sec. | S | | T | R | | | |
| | S | | T | R | | | |
4. Lot No. _____, Recorded Plat _____
5. Private Claims _____

Compliance with
ACT 345, P.A. 1990

APPROVED ON: 11-30-95
WAYNE COUNTY REMONUMENTATION
PEER GROUP COMMITTEE

Register of Deeds Stamp and File Number

	A	B	C	D	E	F	G	H	I	J	K	L	M
2	6		5		4		3		2		1		
3													
4	7		8		9		10		11		12		
5													
6	18		17		16		15		14		13		
7													
8	19		20		21		22		23		24		
9													
10	30		29		28		27		26		25		
11													
12	31		32		33		34		35		36		
13													

I, Kenneth S. Wilkerson in a field survey on 06/21/1995
do hereby certify that under requirements of P.A. 74, Michigan P.A. of 1970, the corner points mentioned in lines 1 and 2 above were in conformance with regulations and rules therefore as required in the current manual of survey instructions of the United States Department of the Interior, Bureau of Land Management, or by a decree of a Court of Law and/or that the corner points mentioned in lines 3, 4 and 5 above were in conformance with the rules of the Michigan Board of Land Surveyors or by a Decree of a Court of Law, established, re-established, monumented, re-monumented, recovered, found as expressed below.

NOTE: Not more than 4 corners, all in the same town and range, may be recorded on this certificate.

A. Description of original monument and accessories and/or subsequent restorations:

01/01/1819 Wampler G.L.O. Set post
24" W. OAK N 2 W 9 LINKS (5.94) (GONE)
20" W. OAK S 6 W 60 LINKS (39.60") (GONE)


(Witnesses Continued-on Back ...)

B. Description of corner evidence found and/or method applied in restoring or reestablishing corner:

Fd. 3/4" Hex Bolt in asph. pvm't. @ cl w. bnd. lane Oakville-Waltz Rd. Dist to H-13 = 2632.54' (R) 2633.36' (M) DIST TO G-1, HURON TWP. 7.54 CH 497.64'(R) 496.63(M) NOT A COMMON CORNER

C. Description of monument for corner and accessories established to perpetuate locating the position of the corner:

06/21/1995 Wilkerson 35994 O.H.M. Remon.
SET MON. BOX AND 1/2" I.R. WHERE WE FD. HEX BOLT. SET W.C.
5 SET W.C.R. TAG N/SIDE P.P. S70E 163.04'
6 SET W.C.R. TAG E/SIDE P.P. S65W 78.71'
7 SET W.C.R. TAG E./S TREE N20W 48.12'
8 TOP BOLT ON HYD. N85E 280.44'
9 TOP BOLT ON HYDRANT N 77 E 79.17'

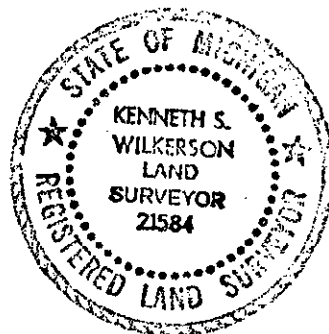

We conclude that after careful study of the record documentation and field observations, that this corner is accepted as the best available evidence of the position of the original corner.

Signed by Kenneth S. Wilkerson
Drafted by Kenneth S. Wilkerson
Surveyor's Michigan License No. 21584
Orchard, Hiltz and McCliment, Inc. 34935 Schoolcraft Road Livonia, MI 48150

Date Dec 8 1995

\$ 10.00 DEED
21 DEC 95 9:18 A.M. RECEIPT# 58
RECORDED
FOREST E. YOUNGBLOOD, REGISTER OF DEEDS
WAYNE COUNTY, MI
\$ 4.00 REMONUMENTATION

95273113

APR 10 1995

A. (Continued) Description of original monument and accessories and/or subsequent restorations:

01/01/1930

Wayne Co.
Bureau of
Taxation

Mon.

- 1 ED. POLE N.E. 49.32' (GONE)
- 2 30" POPLAR N.W. 77.97' (GONE)
- 9 DIST = 2632.54' TO H-13

LIBER 28477 PAGE 195

03/10/1972

Reynolds

W.C.R.C.

Mon.

- 2 35" POPLAR N.W. 77.74 (GONE)
- 3 SPIKE IN FENCE POST N.E. 42.38' (GONE)
- 4 DBL. HEAD SPIKE N.E. 173.13' (GONE)
- 5 P.K. NAIL IN M.B.T. POLE S.E. 163.14'
- 6 P.K. IN M.B.T. POLE S.W. 79.15'

FILED DO NOT MAIL