

LAND CORNER RECORDATION CERTIFICATE

Filing Requirement of Act 74, Mich. P.A. 1970

I-10 Page 1

For corners in

Wayne

Located in: Sumpter Corner Code

LI 29366 PA 889

- | | | | |
|---------------------------------------|---------|---------------------------|-------|
| 1. Public Land Survey | | T <u>4</u> S R <u>8</u> E | I-10 |
| | | T _____ R _____ | _____ |
| | | T _____ R _____ | _____ |
| | | T _____ R _____ | _____ |
| 2. Property Controlling in Section | S _____ | T _____ R _____ | _____ |
| | S _____ | T _____ R _____ | _____ |
| 3. Miscellaneous Property in Sec. | S _____ | T _____ R _____ | _____ |
| | S _____ | T _____ R _____ | _____ |
| 4. Lot No. _____, Recorded Plat _____ | | | |
| 5. Private Claims _____ | | | |

Compliance with
ACT 345, P.A. 1990

APPROVED ON: 12-16-96 *DOJ*
WAYNE COUNTY REMONUMENTATION
PEER GROUP COMMITTEE

Register of Deeds Stamp and File Number

I, Kenneth S. Wilkerson in a field survey on 02/01/1996
do hereby certify that under requirements of P.A. 74, Michigan P.A. of 1970, the corner points mentioned in lines 1 and 2 above were in conformance with regulations and rules therefore as required in the current manual of survey instructions of the United States Department of the Interior, Bureau of Land Management, or by a decree of a Court of Law and/or that the corner points mentioned in lines 3, 4 and 5 above were in conformance with the rules of the Michigan Board of Land Surveyors or by a Decree of a Court of Law, established, re-established, monumented, re-monumented, recovered, found as expressed below.

NOTE: Not more than 4 corners, all in the same town and range, may be recorded on this certificate.

	A	B	C	D	E	F	G	H	I	J	K	L	M
2	6	5	4	3	2	1							
3													
4	7	8	9	10	11	12							
5													
6	18	17	16	15	14	13							
7													
8	19	20	21	22	23	24							
9													
10	30	29	28	27	26	25							
11													
12	31	32	33	34	35	36							
13													

A. Description of original monument and accessories and/or subsequent restorations:

01/01/1816 Wampler G.L.O. Set post
REMAIN AT THIS CORNER
NO WITNESSES

(Witnesses Continued on Back ...)

B. Description of corner evidence found and/or method applied in restoring or reestablishing corner:

Fd. 1/2" iron rod dist to I-09 = 2645.85'(R) 2645.98'(M) and to I-11 = 2646.22'(R)

C. Description of monument for corner and accessories established to perpetuate locating the position of the corner:


02/01/1996 Wilkerson 21584 O.H.M. Remon
SET W.C.R CAP AND WASHER OVER FD. 1/2" I.R. IN GRAVEL RD.
8 N 90 W Fd. 1" IRON PIPE 32.86'
9 S 15 E Fd. PK NAIL E SIDE GUY POLE 107.25'
12 N 35 W Fd. NAIL IN 30" TREE 62.05'
13 S 20 W Fd NAIL IN W SIDE M.B.T. POLE 103.35'

\$ 4.00 REMONUMENTATION
30 DEC 96 1:37 P.M. RECEIPT# 448
RECORDED
FOREST E. YOUNGBLOOD, REGISTER OF DEEDS
WAYNE COUNTY, MI
\$ 10.00 DEED

We conclude that after careful study of the record documentation and field observations, that this corner is accepted as the best available evidence of the position of the original corner.

Signed by *Kenneth S. Wilkerson*
Drafted by Kenneth S. Wilkerson
Surveyor's Michigan License No. 21584
Orchard, Hiltz and McCliment, Inc. 34935 Schoolcraft Road Livonia, MI 48150

Date Dec 26, 1996

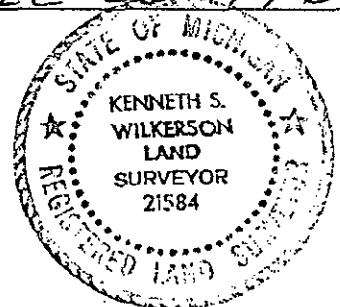

46
10L
DOJ

A. (Continued) Description of original monument and accessories and/or subsequent restorations:

01/01/1930

W.C. B/T

Iron

- 1 FENCE POST NE 52.05' (GONE)
- 2 ED. POLE NE 31.59' (GONE)
- 3 FENCE POST E 33.59' (GONE)
- 4 FENCE POST SE 46.36' (GONE)
- 5 S. FENCE POST SW 59.40' (GONE)
- 6 FENCE POST W 33.13' (GONE)
- 7 N FENCE POST NW 48.86' (GONE)

LI29356PA890

06/08/1970

W.C.R.C.

Iron

- 8 IRON W 32.86'
- 9 GUIDE POLE SE 106.19'
- 10 M.B.T. POLE SW 50.00'
- 11 10" OAK NW 132.30'

06/16/1970

Johns

W.C.R.C.

Iron

SAME AS ABOVE